

NOTES

GENERAL

- THE LOCATIONS OF EXISTING UNDERGROUND UTILITIES ARE SHOWN IN AN APPROXIMATE WAY ONLY. THE CONTRACTOR SHALL DETERMINE THE EXACT LOCATION OF ALL EXISTING UTILITIES BEFORE COMMENCING WORK. HE AGREES TO BE FULLY RESPONSIBLE FOR ANY AND ALL DAMAGES WHICH MIGHT BE OCCASIONED BY HIS FAILURE TO EXACTLY LOCATE AND PRESERVE ANY AND ALL UNDERGROUND UTILITIES. DIGLINE TELEPHONE NUMBER 1-208-342-1585.
- ALL LOT DIMENSIONS AND EASEMENTS SHALL BE TAKEN FROM THE PLAT OF THIS SUBDIVISION.
- ALL WATER, SEWER AND SERVICES LINES SHALL BE INSTALLED, COMPLETE, PRIOR TO CURB, GUTTER AND SIDEWALK CONSTRUCTION.
- CONTRACTOR SHALL OBTAIN CONSTRUCTION PERMIT FROM ADA COUNTY HIGHWAY DISTRICT (ACHD) 24 HOURS BEFORE COMMENCING CONSTRUCTION. NO CONSTRUCTION SHALL BEGIN BEFORE PRECONSTRUCTION MEETING IS HELD ACCORDING TO THE "CONSTRUCTION QUALITY ASSURANCE MANUAL". THE CONTRACTOR IS REQUIRED TO ATTEND THE PRECONSTRUCTION MEETING.
- NO PAVING SHALL OCCUR UNTIL THE CONTRACTOR OBTAINS WRITTEN APPROVAL OF ALL INSTALLED WATER, SEWER, AND PRESSURE IRRIGATION FACILITIES FROM THE CITY OF KUNA.
- ALL CONSTRUCTION SHALL COMPLY WITH THE LATEST EDITION OF THE IDAHO STANDARDS FOR PUBLIC WORKS CONSTRUCTION (ISPW).
- THE STREET CONTRACTOR SHALL CLEAN UP AND FINE GRADE THE ENTIRE SUBDIVISION AT THE COMPLETION OF THE PROJECT.
- STIMONSITE MODEL 8848 BLUE REFLECTIVE MARKER (OR APPROVED EQUAL) SHALL BE INSTALLED 6" OFF OF STREET CENTERLINE AND PERPENDICULAR TO EACH FIRE HYDRANT. IT SHALL BE LOCATED ON THE SIDE OF THE STREET NEAREST THE FIRE HYDRANT.

STREETS

- ALL CONSTRUCTION IN THE PUBLIC RIGHT-OF-WAY SHALL CONFORM TO THE 2003 EDITION OF THE I.S.P.W.C. AND THE ACHD SUPPLEMENTAL SPECIFICATIONS. NO EXCEPTIONS TO DISTRICT POLICY, STANDARDS, AND THE I.S.P.W.C. WILL BE ALLOWED UNLESS SPECIFICALLY APPROVED IN WRITING BY THE DISTRICT.
- STANDARD SEWER AND STORM DRAIN MANHOLES, CONES AND STRUCTURES SHALL BE SET TO SPECIFIED ELEVATION BY THEIR RESPECTIVE CONTRACTORS. ALL REMAINING MANHOLE MATERIALS, EXCEPT CONCRETE COLLARS, NECESSARY TO CONSTRUCT MANHOLE TO FINISHED GRADE IN PAVEMENT AREAS SHALL BE FURNISHED BY THE PIPE CONTRACTORS FOR PLACEMENT AT FINISHED GRADE BY STREET CONTRACTOR. FOR MANHOLES NOT WITHIN PAVEMENT AREAS, THE MANHOLE RINGS SHALL BE SET TO FINISHED GRADE BY THEIR RESPECTIVE CONTRACTORS. ALL MATERIALS FOR CONCRETE COLLARS AROUND SANITARY SEWER AND STORM DRAIN MANHOLE RINGS SHALL BE SUPPLIED AND CONSTRUCTED TO FINISHED GRADE BY STREET CONTRACTOR IN ACCORDANCE WITH ISPW SPECIFICATIONS.
- ALL WORK WILL BE INSPECTED BY THE ACHD IN ACCORDANCE WITH THE LATEST EDITION OF THE "CONSTRUCTION QUALITY ASSURANCE MANUAL".
- STORM DRAIN PIPE IN STREETS SHALL UTILIZE TYPE I BEDDING MATERIAL, PLACED IN 6" LAYERS AS PER ACHD TYPICAL TRENCH DETAIL, DRAWING NO. SD-301. THE PIPE SHALL BE HDPE, ADS N-12 OR EQUAL.
- CONCRETE CONTRACTOR SHALL CALL BRIGGS ENGINEERS, INC. (BE) AT LEAST 24 HOURS IN ADVANCE FOR STRING LINE INSPECTION PRIOR TO POURING ANY CONCRETE. THIS INSPECTION BY BEI DOES NOT RELIEVE THE CONTRACTOR FROM THE RESPONSIBILITY OF COMPLYING WITH THE INTENT OF THE PLANS AND SPECIFICATIONS.
- THE STREET CONTRACTOR SHALL BACKFILL ALL SIDEWALKS AT THE COMPLETION OF THE PAVING.


WATER DISTRIBUTION

- ALL WATER LINES SHALL BE CONSTRUCTED IN ACCORDANCE WITH THE LATEST EDITION OF THE IDAHO RULES FOR PUBLIC DRINKING WATER SYSTEMS, (DAPA 58.01.08), THE LATEST EDITION OF THE IDAHO STANDARDS FOR PUBLIC WORKS CONSTRUCTION, UNIFORM PLUMBING CODE, AND LAWS OF THE STATE OF IDAHO.
- CONTRACTOR SHALL NOTIFY KUNA CITY AND THE DEVELOPER'S ENGINEER 72 HOURS BEFORE CONSTRUCTION BEGINS. THE KUNA CITY AND THE DEVELOPER'S ENGINEER SHALL BE ALLOWED TO INSPECT WATER LINES BEFORE BACKFILLING.
- TRENCH BACKFILL ABOVE THE PIPE ZONE WILL BE INSPECTED BY THE ADA COUNTY HIGHWAY DISTRICT AND SHALL MEET THEIR MATERIAL AND COMPACTION REQUIREMENTS.
- ALL WATER MAINS SHALL BE POLY-VINYL-CHLORIDE (PVC) CONFORMING TO THE PROVISIONS OF ANWA C-900, CLASS 150, SDR 18, OR CLASS 150 CEMENT MORTAR LINED DUCTILE IRON CONFORMING TO ANWA C-104 AND ANWA C-151. ALL FITTINGS SHALL BE MECHANICAL JOINT DUCTILE IRON FITTINGS CONFORMING TO ANWA C-110. ALL PLASTIC PIPE SHALL BE INSTALLED WITH 1/2" DIRECT BURIAL TRACER WIRE PLACED ALONG THE NORTH AND EAST SIDE OF THE MAIN. THE TRACER WIRE SHALL BE ACCESSIBLE AT ALL VALVE BOXES AND SHALL BE EXTENDED ALONG THE OUTSIDE OF THE LOWER PORTION OF THE VALVE BOX AND ALONG THE INSIDE OF THE UPPER PORTION. MINIMUM BURIAL DEPTH FOR ALL WATER MAINS SHALL BE 4 FEET FROM FINISH GRADE TO THE TOP OF PIPE.
- ALL MAIN LINE WATER VALVES SHALL BE RESILIENT-SEATED GATE VALVES CONFORMING TO ANWA C-509. ALL WATER VALVES SHALL BE FURNISHED WITH A STANDARD CAST IRON 5-1/4" INCH DIAMETER ADJUSTABLE VALVE BOX. THE CAST IRON COVER SHALL BE MARKED WITH THE WORD "WATER" AS AN INTEGRAL PART OF THE COVER.
- ALL FIRE HYDRANTS SHALL BE DRY BARREL FIRE HYDRANTS CONFORMING TO ANWA C-502. HYDRANTS SHALL HAVE A 5-FOOT SETTING; MINIMUM 5-1/4" INCH VALVE OPENING; 150 PSI WORKING PRESSURE; ONE 4-1/2" INCH DIAMETER NATIONAL STANDARD FLUMPER NOZZLE; AND TWO 2-1/2" INCH DIAMETER NATIONAL STANDARD THREADED FIRE HOSE NOZZLES. THE VALVE OPERATOR SHALL OPEN LEFT (COUNTERCLOCKWISE). THE HYDRANT SHALL BE EQUIPPED WITH A BREAKABLE TRAFFIC FLANGE JUST ABOVE-GROUND LEVEL; A DRAIN THAT AUTOMATICALLY OPENS WHEN THE HYDRANT IS CLOSED; AND A 6-INCH FLANGED CONNECTION. THE HYDRANT SHALL BE EQUIPPED WITH A 6-INCH FLANGED (BY MECHANICAL JOINT) RESILIENT-SEAT GATE VALVE WITH CAST IRON VALVE BOX ATTACHED DIRECTLY TO THE MAIN LINE TEE. FIRE HYDRANTS SHALL BE INSTALLED SUCH THAT THE BREAKABLE TRAFFIC FLANGE IS SET 2-INCHES MINIMUM, 6-INCHES MAXIMUM ABOVE THE BACK OF SIDEWALK OR FINISH GRADE, AS APPLICABLE. HYDRANT SPACING SHALL BE 450'. APPROVED FIRE HYDRANTS ARE CLOW MEDALLION, WATERLOUS PAKER 100, AND MUELLER 4423. NO OTHER MODELS ARE ALLOWED.
- INDIVIDUAL WATER SERVICES SHALL BE INSTALLED FOR EACH CONNECTION. THE WATER SERVICE SHALL CONSIST OF A PIPE SADDLE WITH 1-INCH COPPER STOP; 1-INCH CLASS 200, SDR 7.3 POLYETHYLENE PIPE CONFORMING TO ANWA C-901; 18-INCH TALL 5/8"x3/4" COPPER METER SETTER WITH LOCKABLE SHUTOFF VALVE; INTEGRAL CHECK VALVE; 10-FOOT LONG SLUG 1-INCH PIPE AT CUSTOMER SIDE. 18-INCH DIAMETER BY 30-INCH TALL METER BOX WITH CAST IRON FRAME AND COVER APPROVED BY THE CITY. COVER SHALL HAVE 1-INCH HOLE. FOR INSTALLATION OF AUTO-READ SENSOR (BY OTHERS), METER BOX SHALL BE INSULATED, SIMILAR TO MID STATES PLASTIC "THERMO PACK".
- MULTIPLE TAPS IN THE SAME PIPE JOINT SHALL BE STAGGERED AND SHALL BE SEPARATED BY A MINIMUM OF ONE FOOT. THE CENTERLINE OF THE METER SETTER SHALL BE LOCATED 18-INCHES BELOW FINISH GRADE. METERS SHALL BE PLACED 18 INCHES INSIDE THE PROPERTY LINE OF ACHD EASEMENT, OR A MINIMUM OF 18" BEHIND MAILBOX CLUSTERS AND 18-INCHES AWAY FROM THE SIDE LOT LINE. DUAL SERVICES OFF ONE SERVICE LINE WILL NOT BE ALLOWED.
- ALL INSTALLED WATER LINES SHALL BE TESTED FOR LEAKAGE IN ACCORDANCE WITH SECTION 401 OF THE ISPW SPECIFICATIONS FOLLOWING INSTALLATION OF ALL UTILITIES AND PRIOR TO PAVING. THE TESTING MUST BE OBSERVED BY A REPRESENTATIVE OF THE CITY. ALL INSTALLED WATER LINES SHALL BE DISINFECTED IN ACCORDANCE WITH SECTION 801 OF THE ANWA SPECIFICATIONS AND SATISFACTORILY PASS A BACTERIOLOGICAL TEST CONDUCTED BY THE CITY PRIOR TO BEING PUT INTO SERVICE.
- ALL PIPE, MAINS AND SERVICES, SHALL BE BEDDED WITH TYPE I BEDDING. IN AREAS OF ROCK EXCAVATION BEDDING SHALL BE 6-INCHES BELOW THE PIPE.
- IN AREAS WHERE ROCK EXCAVATION IS REQUIRED ALL BLASTING FOR OTHER UTILITIES SHALL OCCUR PRIOR TO INSTALLATION OF ANY SEWER MAINS, WATER MAINS OR SERVICE LINE CROSSINGS.
- ALL TEES, PLUGS, CAPS AND BENDS OF 22 1/2" AND AT OTHER LOCATIONS WHERE UNBALANCED FORCES WILL EXIST SHALL BE SECURED AND ANCHORED BY SUITABLE THRUST BLOCKING MEETING THE REQUIREMENTS OF ISPW SD-403.
- WHEN CONSTRUCTION IS SATISFACTORILY COMPLETED, CLEANED AND TESTED THE CONTRACTOR SHALL REQUEST A FINAL ACCEPTANCE INSPECTION BY THE CITY. THE FINAL ACCEPTANCE INSPECTION SHALL OCCUR AFTER ALL OTHER UTILITIES ARE INSTALLED. AT A MINIMUM, THE FINAL ACCEPTANCE INSPECTION SHALL CONSIST OF WITNESSING A FINAL WATER PRESSURE TEST CONDUCTED BY THE CONTRACTOR.
- THE CITY HAS THE RIGHT TO INSPECT THE WORK AT ANY TIME DURING CONSTRUCTION. ANY WORK THAT DOES NOT CONFORM TO THE APPROVED PLANS AND SPECIFICATIONS SHALL BE REJECTED.
- THE DEVELOPER AND CONTRACTOR SHALL GUARANTEE ALL WORK FOR A PERIOD OF ONE YEAR FOLLOWING ACCEPTANCE BY THE CITY.

NOTES

SANITARY SEWER

- PRIOR TO CONSTRUCTION, IT SHALL BE THE RESPONSIBILITY OF THE CONTRACTOR TO INFORM ALL THE UTILITY COMPANIES OF THE CONSTRUCTION SCHEDULE.
- ALL UTILITY LOCATIONS AND DEPTHS ARE APPROXIMATE.
- ALL ELEVATIONS ARE BASED ON U.S.G.S. DATUM.
- MANHOLE RIM ELEVATIONS AS SHOWN ON THE CONSTRUCTION DRAWINGS ARE APPROXIMATE. THE MANHOLE FRAMES AND COVERS SHALL BE CONSTRUCTED IN ACCORDANCE WITH ACHD'S REVISION TO THE I.S.P.W.S. STANDARD DRAWING NO. SD 508.
- CONTRACTOR SHALL REPAVE ANY EXISTING PAVED STREETS DISTURBED DURING CONSTRUCTION.
- RETAIN AND PROTECT ALL IRRIGATION AND DRAINAGE PIPE CROSSINGS. THE CONTRACTOR SHALL COORDINATE WITH THE OWNER AND THE ACHD FOR THE INSPECTION OF THE EXPOSED IRRIGATION AND/OR DRAINAGE PIPE CROSSINGS. IF EXISTING PIPES ARE DAMAGED, THE AFFECTED PIPE WILL BE REPLACED BY THE CONTRACTOR.
- RETAIN AND PROTECT WATER METER VALVES. IF THE VALVES ARE DISTURBED, THE CONTRACTOR SHALL CONTACT THE APPROPRIATE WATER COMPANY FOR REPLACEMENT.
- RETAIN AND PROTECT EXISTING CURB, GUTTER AND SIDEWALK. IF REMOVAL IS NECESSARY, REPLACEMENT SHALL BE INCIDENTAL TO THE PROJECT.
- THE FOLLOWING TYPE AND CLASS OF PIPE WILL BE PERMITTED: PIPE SHALL CONFORM TO A.S.T.M. D 3034 P.V.C., SDR 35.
- ALL WORK SHALL BE CONSTRUCTED TO I.S.P.W.C. STANDARDS, UNIFORM PLUMBING CODE, LAWS OF THE STATE OF IDAHO AND SHALL BE APPROVED BY KUNA CITY.
- THE SEWER CONTRACTOR SHALL OBTAIN A STREET EXCAVATION PERMIT.
- SEWER MANHOLES SHALL BE TYPE "A".
- SANITARY SEWER MANHOLES SHALL BE CONSTRUCTED OF REINFORCED PRECAST CONCRETE 4' DIAMETER WITH CONC. MINIMUM 12" OF CONCRETE GRADE RINGS AND 24" C.I. RING AND COVER. MANHOLE REINFORCING AND STRENGTH REQUIREMENTS SHALL CONFORM TO A.S.T.M. C-478 SPECIFICATIONS.
- AN ECCENTRIC CONE SHALL BE PLACED ON SANITARY SEWER MANHOLES GREATER THAN 4 FEET DEEP, WITH THE VERTICAL WALL PLACED ON THE UPSTREAM SIDE AND ROTATED 45°. MANHOLES LESS THAN 4 FEET DEEP SHALL HAVE CONCENTRIC CONES. MANHOLES OVER 4' DEEP SHALL HAVE STEPS.
- SANITARY SEWER MANHOLE CONES SHALL BE SET A MAXIMUM OF ONE (1) FOOT BELOW SPECIFIED RING ELEVATIONS BY SEWER CONTRACTOR. ALL REMAINING MANHOLE MATERIALS, OTHER THAN CONCRETE COLLARS NECESSARY TO CONSTRUCT MANHOLE TO FINISHED GRADE, SHALL BE FURNISHED BY THE SEWER CONTRACTOR FOR PLACEMENT AT FINISHED GRADE BY STREET PAVING CONTRACTOR. ALL MATERIALS FOR CONCRETE AROUND MANHOLE RINGS SHALL BE SUPPLIED AND CONSTRUCTED TO FINISHED GRADE BY STREET CONTRACTOR. THE CITY OF KUNA SHALL BE CONTACTED 24 HOURS PRIOR TO PLACING CONCRETE COLLARS.
- THE TRENCH BACKFILL ABOVE THE PIPE ZONE WILL BE INSPECTED BY THE ACHD OR BY THE OWNER'S ENGINEER IN ACCORDANCE WITH THE LATEST EDITION OF THE "CONSTRUCTION QUALITY ASSURANCE MANUAL".
- WHERE PVC IS UTILIZED, A NON-BL-BL FLEXIBLE MANHOLE CONNECTOR OR APPROVED EQUIPMENT IS TO BE INSTALLED WHERE THE PIPE CONTACTS THE MANHOLE BASE AND/OR MANHOLE CHANNEL IN ORDER TO INSURE A WATER TIGHT SEAL.
- WHERE IT IS NECESSARY FOR SEWER AND WATER TO CROSS EACH OTHER AND THE SEWER LINE IS ABOVE OR LESS THAN 18 INCHES BELOW THE WATER MAIN, THE SEWER LINE CROSSING SHALL BE IN ACCORDANCE WITH THE LATEST EDITION OF DAPA 58.01.08, SECTION 550.08.
- WHERE THE SEWER MAIN DEPTH WILL ALLOW, ALL SEWER SERVICE LINES SHALL BE CONSTRUCTED TO A DEPTH OF 6.5' AT PROPERTY LINE. THE CONTRACTOR SHALL USE 4" DIAMETER PVC PIPE OR APPROVED EQUIPMENT FOR ALL SERVICES LINES. ALL SEWER SERVICE LINES SHALL BE CONSTRUCTED AT A MINIMUM GRADE OF 1%.
- SEWER SERVICE LINES SHALL BE CONSTRUCTED TO A POINT 10' INSIDE THE BACK OF PROPERTY LINE AS SHOWN, EXCEPT WHERE OTHERWISE INDICATED. THE SEWER SERVICE LINES SHALL BE CONSTRUCTED TO THE MIDPOINT OF THE FRONT LOT LINES. A 2" X 4" MARKER WITH GALVANIZED FINDER WIRE SHALL EXTEND FROM THE END OF EACH SERVICE LINE TO THE FINISHED GROUND SURFACE DIRECTLY ABOVE AND MUST BE PRESENT FOR FINAL INSPECTION (SEE DETAIL). AN ALTERNATE TO GALVANIZED FINDER WIRE MAY BE USED SUBJECT TO CITY APPROVAL PRIOR TO INSTALLATION.
- KUNA CITY AND THE DEVELOPER'S ENGINEER WILL PROVIDE PERIODIC INSPECTION FROM 8:00 A.M. TO 5:00 P.M. DURING A FIVE-DAY WORK-WEEK. THE CONTRACTOR SHALL REIMBURSE THE CITY AND ENGINEER AT RATES EXCESS OF THE NORMAL WORK WEEK, INCLUDING LEGAL HOLIDAYS. OVERTIME RATES AND A LIST OF LEGAL HOLIDAYS CAN BE OBTAINED FROM THE KUNA CITY.
- THE HORIZONTAL SEPARATION OF THE WATER AND SEWER MAINS SHALL BE A MINIMUM OF TEN (10) FEET.
- CONTRACTOR SHALL NOTIFY KUNA CITY AND THE DEVELOPER'S ENGINEER 48 HOURS IN ADVANCE OF CONSTRUCTION.
- WATER LEVELS SHALL BE MAINTAINED BELOW THE TRENCH BOTTOM DURING THE PIPE LAYING AND JOINING OPERATION. THE DOWELLING METHOD SHALL BE DISCUSSED WITH THE ENGINEER AND APPROVED PRIOR TO CONSTRUCTION. DITCHES AND STORM DRAIN FACILITIES THAT ARE SITED UP DUE TO THE CONTRACTOR'S DOWELLING SHALL BE CLEANED AND RESTORED TO THEIR ORIGINAL STATE.
- CONTRACTOR SHALL LOCATE AND PROTECT ALL UNDERGROUND UTILITIES DURING CONSTRUCTION.
- COMPACTION TESTING OF THE SEWER PIPELINE BEDDING WILL BE DONE BY AN OUTSIDE TESTING LABORATORY. THE COST OF THIS SERVICE SHALL BE PAID BY THE DEVELOPER. HOWEVER, IF THE TEST FAILS, THE COST OF THE TEST AND ANY RETESTING SHALL BE PAID BY THE CONTRACTOR. THE CONTRACTOR SHALL COORDINATE WITH THE DEVELOPER'S ENGINEER AND THE TESTING LABORATORY TO SCHEDULE THE TESTS, HIS BACKFILLING, AND PIPE LAYING OPERATION.
- AFTER ALL UTILITIES ARE CONSTRUCTED AND JUST PRIOR TO PAVING, THE CONTRACTOR SHALL PERFORM AN AIR TEST ON THE SEWER SYSTEM IN ACCORDANCE WITH SECTION 506 OF THE ISPW SPECIFICATIONS. A KUNA CITY REPRESENTATIVE SHALL BE PRESENT TO WITNESS THE TEST. THE CONTRACTOR SHALL CONTACT KUNA CITY 24 HOURS PRIOR TO TESTING. DEFLECTION TESTS AND/OR TELEVISION INSPECTION MAY BE REQUIRED AT THE OPTION OF THE CITY.
- WHERE SEWER TAP CONNECTS TO EXISTING MAIN (P.V.C.), HOLE SHALL BE CUT WITH A HOLE SAW. THE CONTRACTOR MAY USE A SADDLE OR "IN-TEE" TO MAKE TAP. A KUNA CITY INSPECTOR MUST BE PRESENT TO WITNESS THE SEWER TAP.
- THE CONTRACTOR SHALL LEAVE THE EXCAVATION FOR THE UPSTREAM END OF ALL SERVICE LINES OPEN FOR FIELD VERIFICATION OF THE INVERT ELEVATION BY THE ENGINEER'S INSPECTOR. THE CONTRACTOR SHALL NOT BACKFILL THE ENDS OF SERVICE LINES UNTIL HE HAS OBTAINED APPROVAL FROM THE CITY OF KUNA INSPECTOR OR MADE OTHER ARRANGEMENTS FOR VERIFICATION OF SERVICE LINE INVERT ELEVATIONS.
- WHEN CONSTRUCTION IS SATISFACTORILY COMPLETED, CLEANED AND TESTED THE CONTRACTOR SHALL REQUEST A FINAL ACCEPTANCE INSPECTION BY THE CITY. THE FINAL ACCEPTANCE INSPECTION SHALL CONSIST OF LAMPING ALL SEWER MAINS, VISUALLY INSPECTING EACH MANHOLE AND WITNESSING A FINAL SEWER AIR TEST CONDUCTED BY THE CONTRACTOR.
- THE CITY HAS THE RIGHT TO INSPECT THE WORK AT ANY TIME DURING CONSTRUCTION. ANY WORK THAT DOES NOT CONFORM TO THE APPROVED PLANS AND SPECIFICATIONS SHALL BE REJECTED.
- THE CONTRACTOR SHALL GUARANTEE ALL WORK FOR A PERIOD OF ONE YEAR FOLLOWING ACCEPTANCE BY THE CITY.
- ALL PIPES, MAINS AND SERVICES SHALL BE BEDDED WITH TYPE I BEDDING. IN AREAS OF ROCK EXCAVATION, BEDDING SHALL BE 6-INCHES BELOW THE PIPE.
- IN AREAS WHERE ROCK EXCAVATION IS REQUIRED, ALL BLASTING FOR OTHER UTILITIES SHALL OCCUR PRIOR TO INSTALLATION OF ANY SEWER MAINS, WATER MAINS OR SERVICE LINE CROSSINGS.

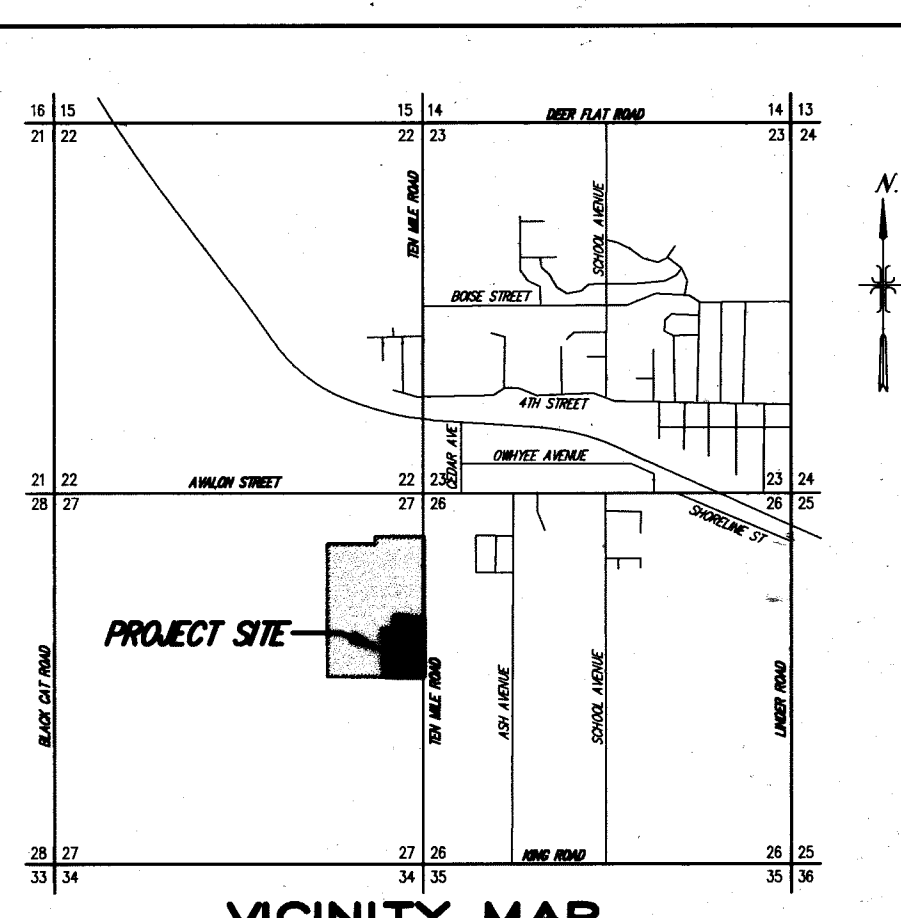

VICINITY MAP

A RESUBDIVISION OF A PORTION OF LOTS 6, 7 AND 8
RADER AND KROEGER'S SUBDIVISION,
LYING IN THE NE 1/4, SECTION 27, T.2N., R.1W., B.M.,
KUNA, ADA COUNTY, IDAHO

ABBREVIATIONS

- ACHD = ADA COUNTY HIGHWAY DISTRICT
- BB = BACK OF CURB TO BACK OF CURB
- B.M. = BENCHMARK
- CONC. = CONCRETE
- DI = DROP INLET
- ELEV. = ELEVATION
- EP = EDGE OF PAVEMENT
- GB = GRADE BREAK
- GRRR = GRAVITY IRRIGATION
- HP = HIGH POINT
- INV. = INVERT
- I.S.P.W.C. = IDAHO STANDARDS FOR PUBLIC WORKS CONSTRUCTION
- LF = LINEAR FEET
- LP = LOW POINT
- LT = LEFT
- MH = MANHOLE
- NTS = NOT TO SCALE
- PIRR = PRESSURE IRRIGATION
- R = RADIUS
- RT = RIGHT
- R/W = RIGHT-OF-WAY
- S = SLOPE
- SD = STORM DRAIN
- SEC. = SECTION
- SH = SAND AND GREASE TRAP
- SI = SANITARY SEWER SERVICE INVERT
- SL = SANITARY SEWER SERVICE LENGTH
- SS = SANITARY SEWER
- SC = SANITARY SEWER SERVICE STATION
- SSMH = SANITARY SEWER MANHOLE
- STA. = STATION
- STW = SIDEWALK
- TBANK = TOP OF BANK
- TBM = TEMPORARY BENCHMARK
- TP = TYPICAL
- W = WATER

REVISION:	BY:
3/22/04	SFT
7/12/04	BPT



BRIGGS ENGINEERING, INC.
ENGINEERS SURVEYORS
PLANNERS
1800 W. OVERLAND ROAD • BOISE, IDAHO 83705 • (208)344-9700
These drawings, or any portion thereof, shall not be used on any Project or extensions of this Project except by written agreement from Briggs Engineering, Inc.

RECORD DOCUMENTS
These Record Documents are based upon the marked-up record drawings, addenda, change orders, and other data furnished by the Contractor and/or public agencies. These Record Documents show significant changes made during construction. Because these Record Documents are based on unverified information provided by other parties, which the Consultant will assume to be reliable, the Consultant cannot and does not warrant their accuracy, except for that information verified by the Engineer.
Benjamin P. Thomas
Signature
Date: 2/18/04

APPROVED FOR CONSTRUCTION


SHEET INDEX

SHEET NO.	DESCRIPTION
1 OF 10	T-1 = TITLE SHEET
2 OF 10	ST-1 = STREET PLAN
3 OF 10	ST-2 = STREET PROFILES
4 OF 10	ST-3 = STREET & IRRIGATION PLAN/PROFILE (Ten Mile Road)
5 OF 10	SS-1 = SANITARY SEWER AND WATER PLAN
6 OF 10	SS-2 = SANITARY SEWER PROFILES
7 OF 10	IRR-1 = IRRIGATION PLAN
8 OF 10	IRR-2 = IRRIGATION DETAILS
9 OF 10	DT-1 = STREET AND STORM DRAIN DETAILS
10 OF 10	DT-2 = SANITARY SEWER AND WATER DETAILS

SUTTER'S MILL NO. 4 SUBDIVISION


TITLE SHEET
DWG. NO. 30204-CYR
SCALE: NTS
DATE: 10/13/03
SFT

SHEET 1 OF 10
T-1
30204-T1-SFT

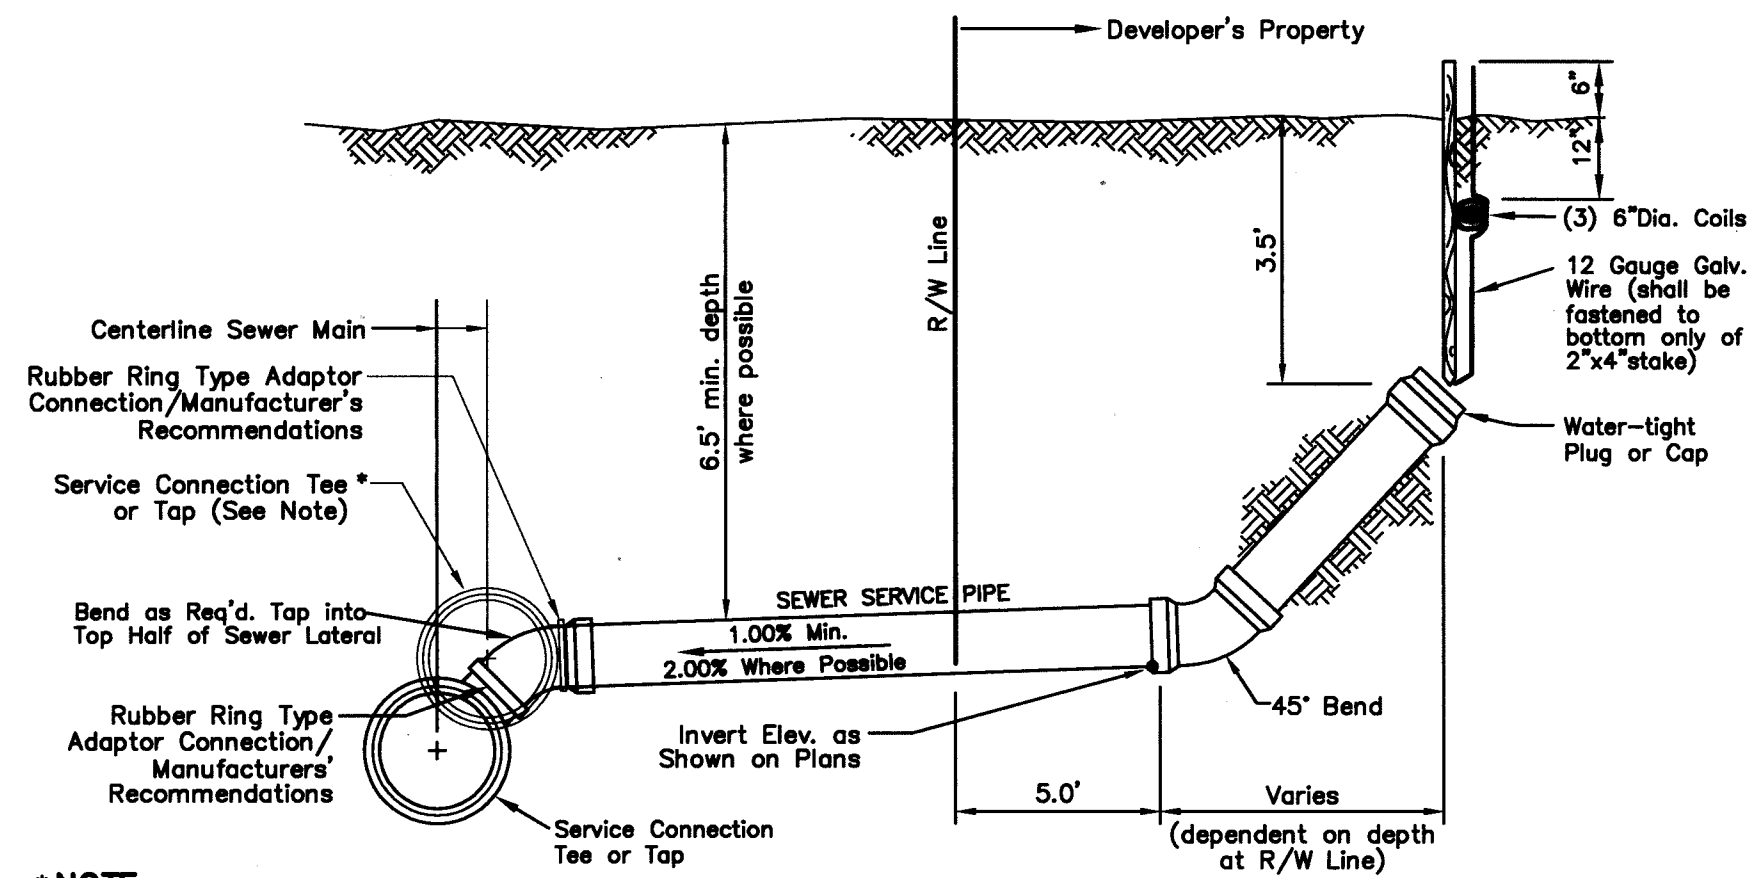


***NOTE**
WHERE SERVICE DEPTH IS LESS THAN 4 FEET AT RIGHT OF WAY LINE INSTALL SERVICE PIPE AT CENTER OF SAN. SEWER MAIN AS SHOWN.

TYPICAL SEWER SERVICE AND MARKER

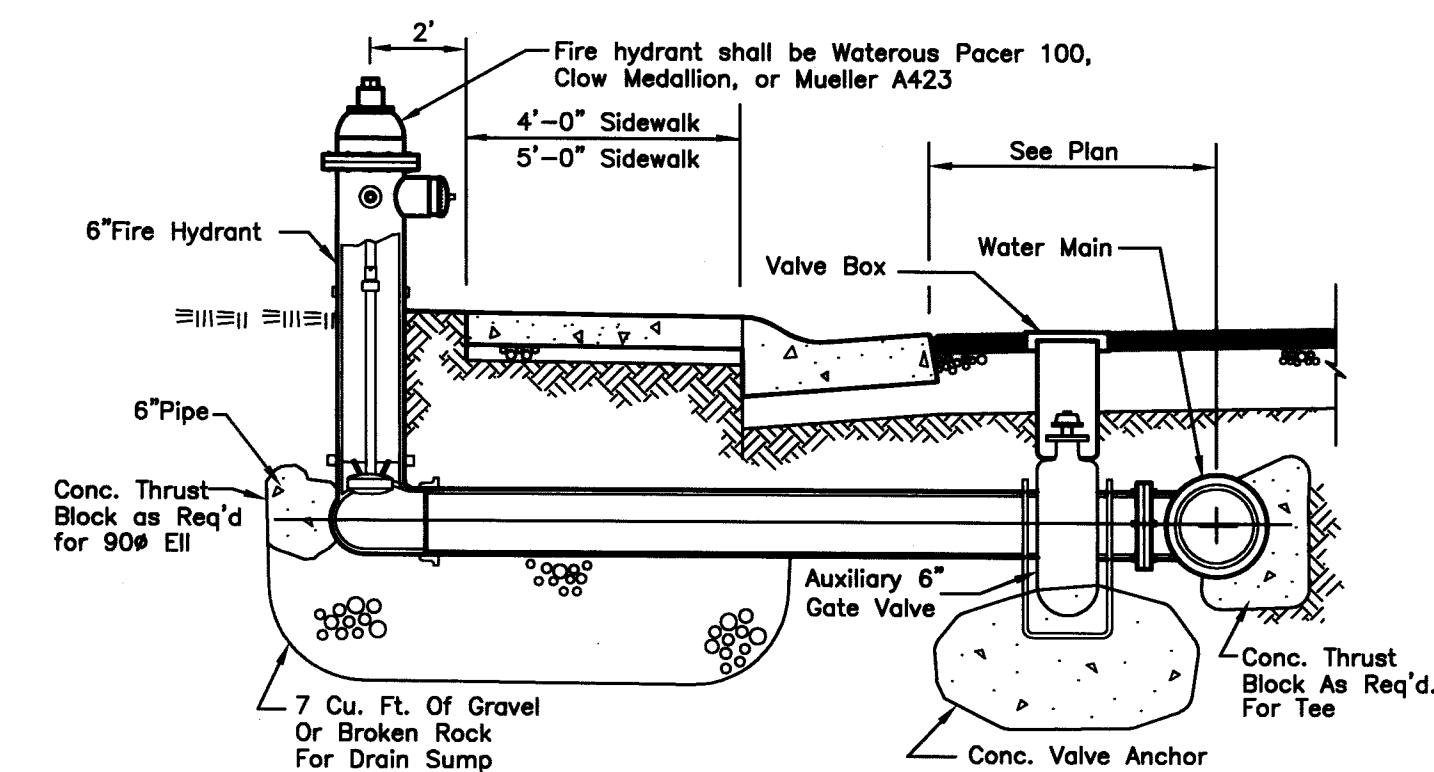

FIRE HYDRANT ASSEMBLY

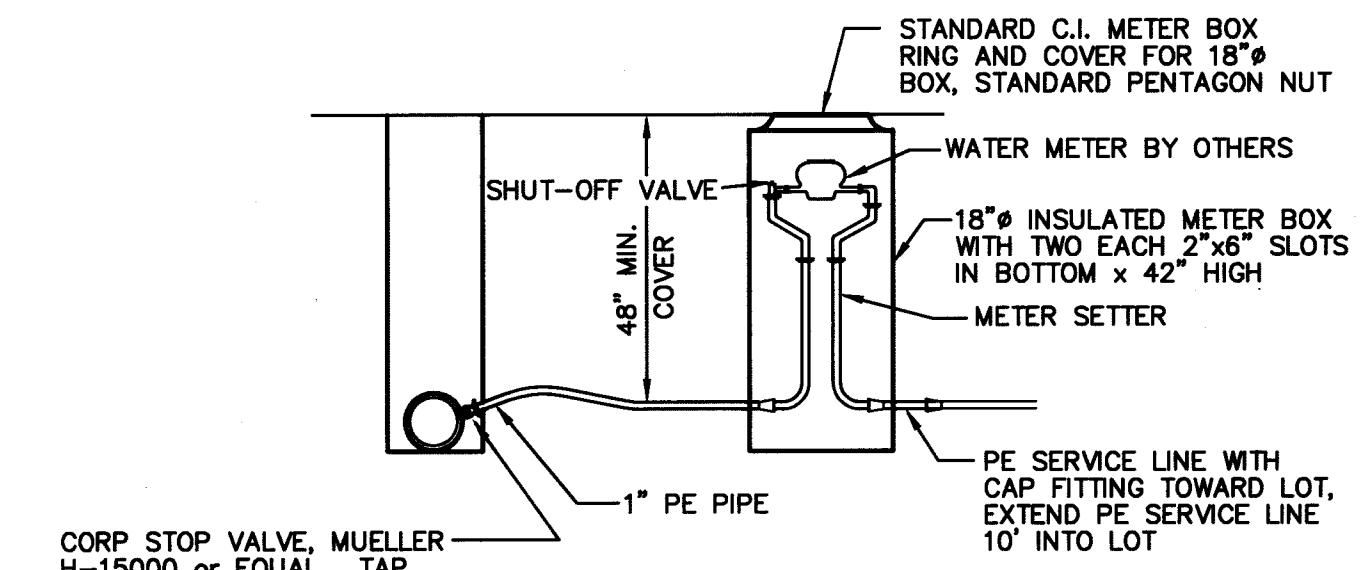


SINGLE WATER SERVICE INSTALLATION


RECORD DOCUMENTS
These Record Documents are based upon the marked-up record drawings, addenda, change orders, and other data furnished by the Contractor and/or public agencies. These Record Documents show significant changes made during construction. Because these Record Documents are prepared by the Consultant, the Consultant cannot and does not warrant their accuracy, except for the information verified by the Engineer.

Signature: *[Signature]* Date: 2/16/04

APPROVED FOR CONSTRUCTION

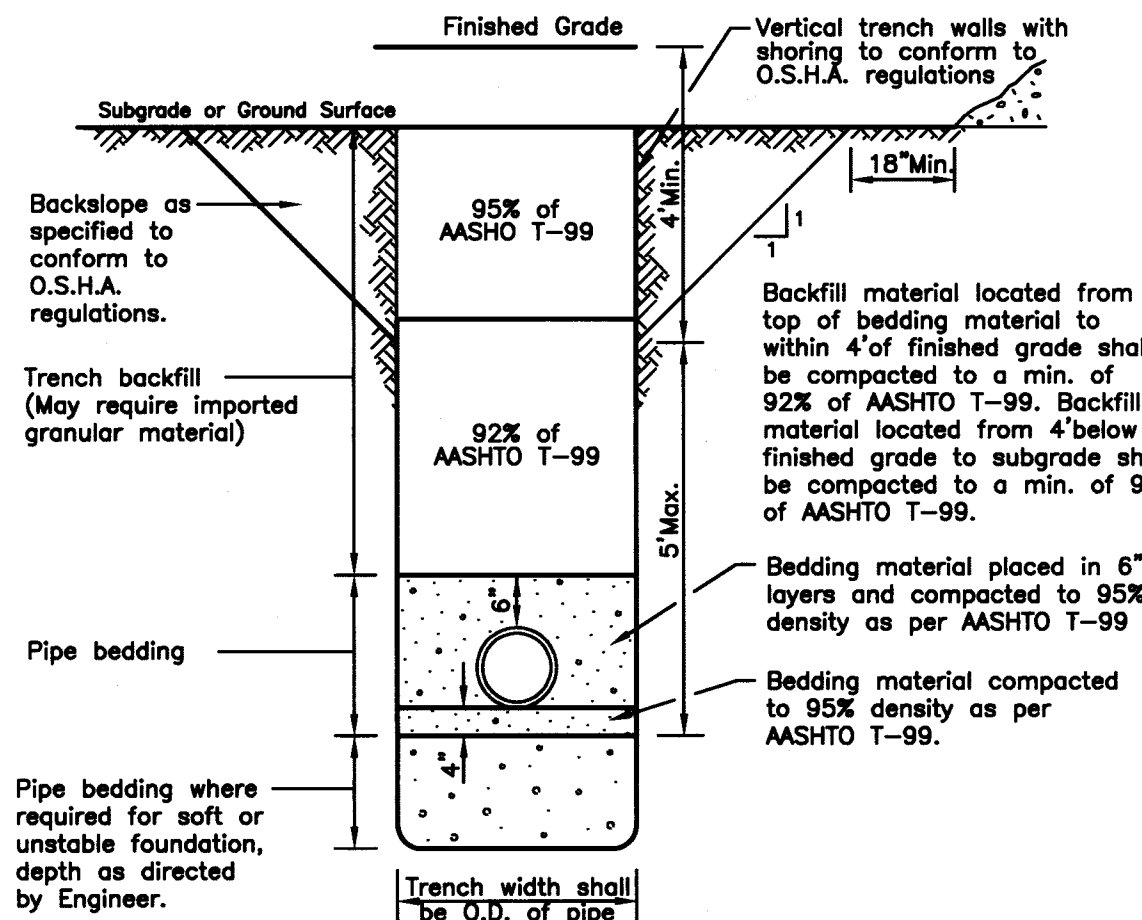


TYPICAL TRENCH DETAIL

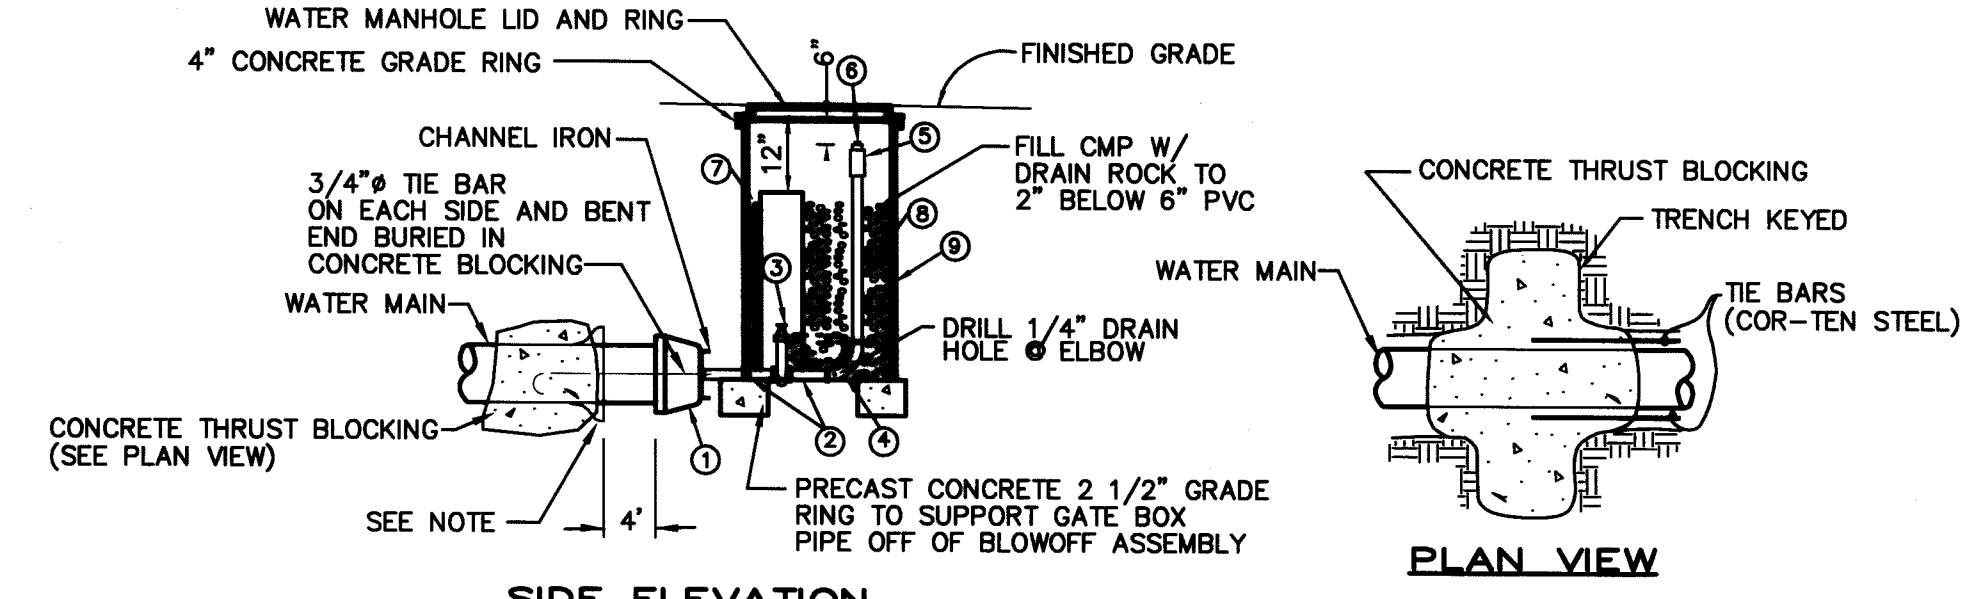

2' BLOW-OFF ASSEMBLY


- EQUIPMENT LEGEND**
- 1 MAIN SIZE M.J. CAP WITH 2" IRON PIPE THREAD OUTLET
 - 2 2"x6" GALVANIZED NIPPLE (THREADED)
 - 3 2" RESILIENT WEDGE SCREWED GATE VALVE OR APPROVED EQUAL
 - 4 2" GALVANIZED 90° ELBOW, THREADED W/ 1/4" DRILLED DRAIN HOLE
 - 5 2" SCHEDULE 40 GALVANIZED MALE ADAPTER (THREADED)
 - 6 2" THREADED FIP x ALUMINUM KAM-LOC QUICK COUPLING MALE ADAPTER WITH CAP
 - 7 PVC PIPE - 6" DIAMETER
 - 8 2" SCHEDULE 40 GALVANIZED PIPE
 - 9 30" DIAMETER CMP

NOTE:
WHEN CONSTRUCTING THIS BLOWOFF FOR A TEMPORARY USE, INSTALL A 3 FOOT LENGTH OF WATER PIPE INTO THE BELL END OF THE LAST LENGTH OF MAIN.

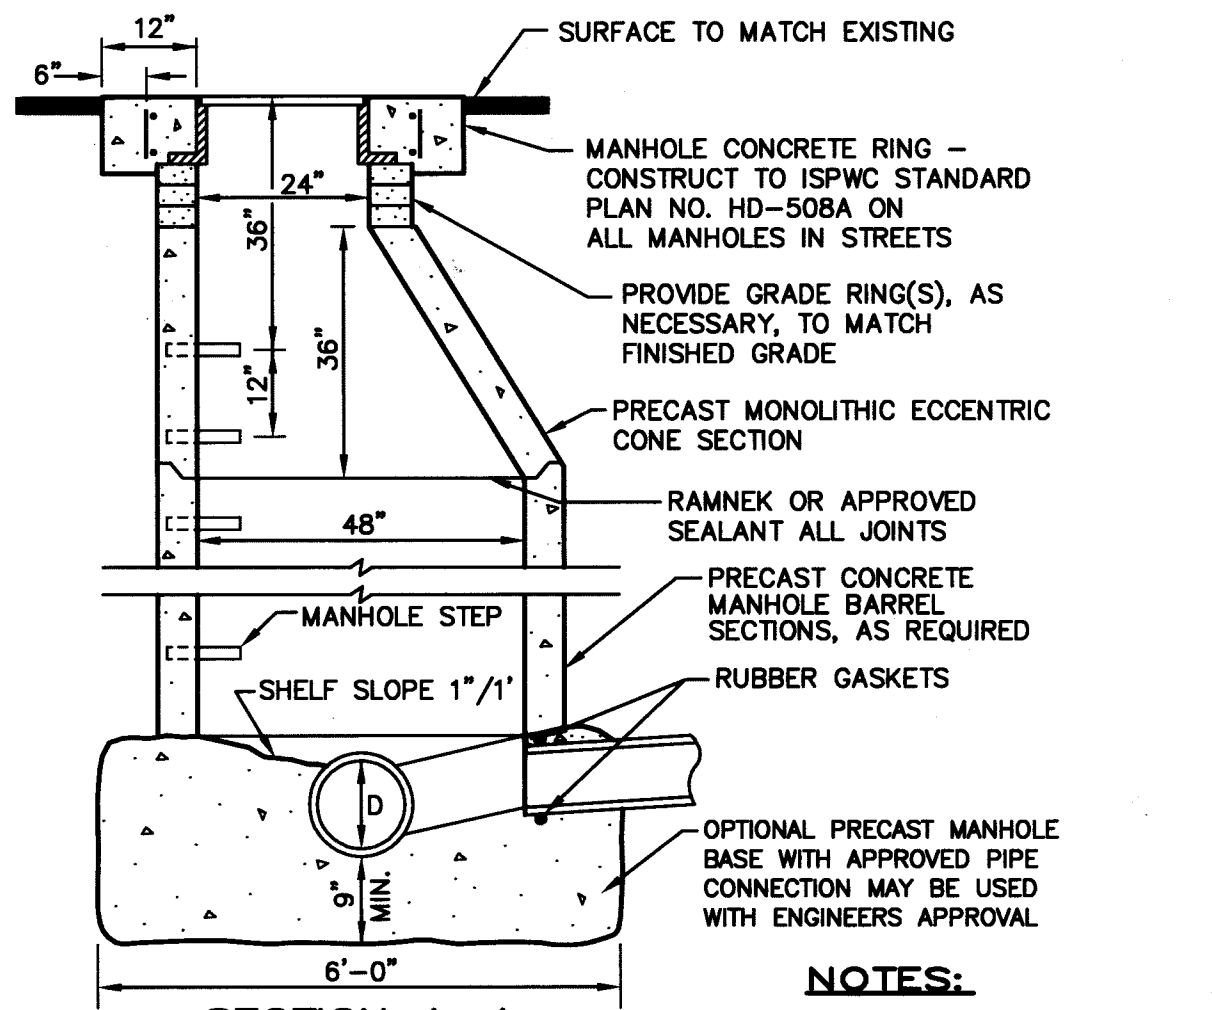


SECTION A-A

- NOTES:**
1. VERTICAL WALL SHALL BE PLACED ON UPSTREAM SIDE OF MANHOLE, ROTATED 45 DEGREES.
 2. FOR PIPE DIAMETER, D, GREATER THAN 24", SEE STANDARD MANHOLE TYPE B OPTIONAL.
 3. MANHOLE FRAME AND COVER: A. SEE DRAWING NO. SD 507 B. FRAME AND COVER SHALL BE FLUSH WITH PAVEMENT.
 4. GRADE RINGS SHALL NOT EXCEED 1'-11" IN HEIGHT.
 5. WHERE PVC IS UTILIZED, A RUBBER RING OR GASKETED COLLAR IS TO BE INSTALLED WHERE THE PIPE IS IN CONTACT WITH MANHOLE BASE AND/OR MANHOLE CHANNEL, IN ORDER TO INSURE A WATERTIGHT SEAL.
 6. EITHER BASE ON STANDARD MANHOLE TYPE B AND TYPE B OPTIONAL MAY BE USED WITH EITHER MANHOLE DESIGN.
 7. TYPE B MANHOLE PER I.S.P.W.C. STD. DWG. SD-502 MAY BE USED IN PLACE OF TYPE B OPTIONAL IF REQUIRED.

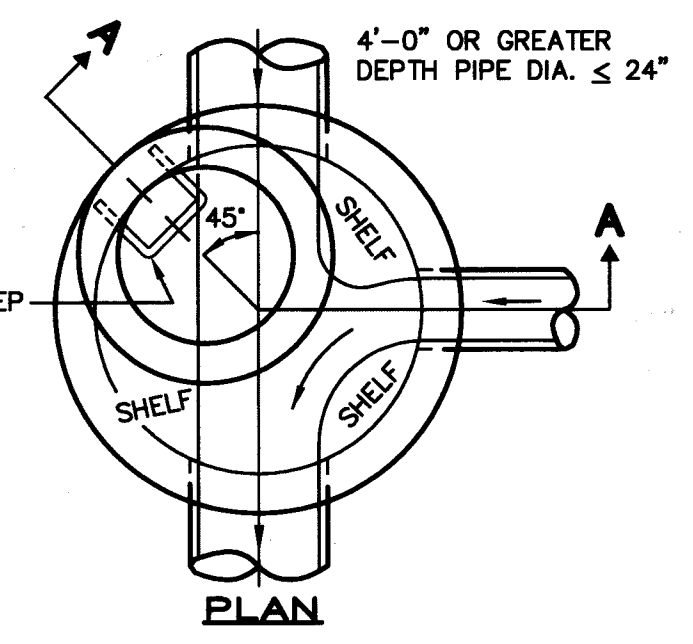

STANDARD MANHOLE - TYPE A

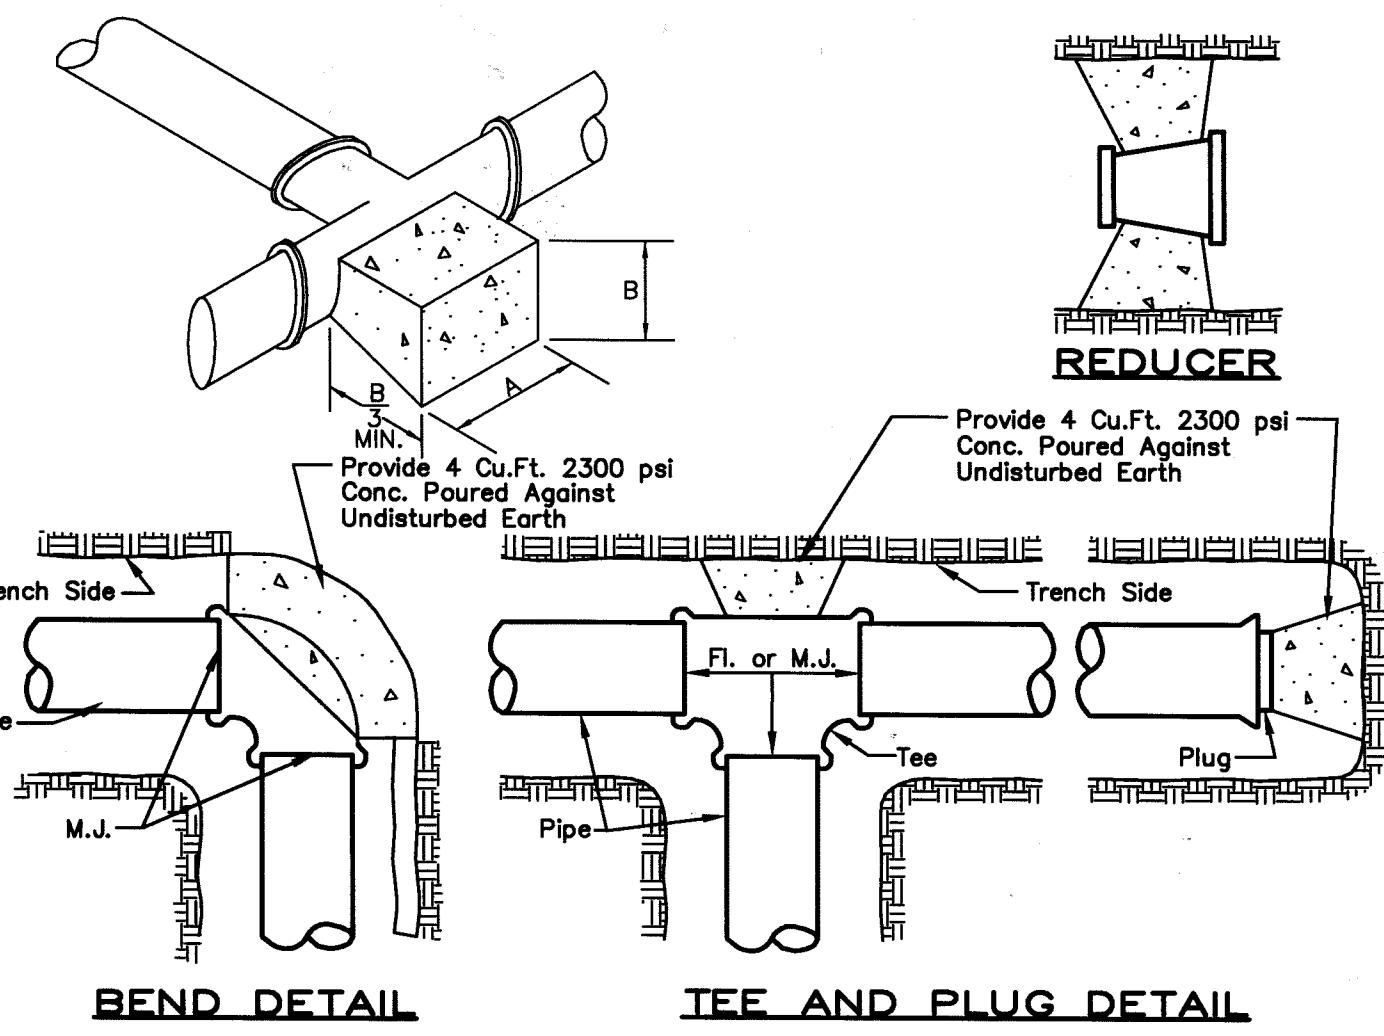


BEND DETAIL TEE AND PLUG DETAIL

TABLE: DIMENSION FOR THRUST BLOCKING

FITTING SIZES	TEES & PLUGS		90° BEND		45° BEND & WYES		REDUCERS & 22 1/2° BEND	
	A	B	A	B	A	B	A	B
4"	1'-7"	1'-2"	1'-9"	1'-6"	1'-8"	0'-10"	1'-7"	0'-6"
6"	2'-0"	1'-11"	2'-5"	2'-2"	1'-10"	1'-7"	1'-9"	0'-10"
8"	2'-8"	2'-6"	3'-2"	3'-0"	2'-5"	2'-1"	1'-9"	1'-6"
10"	3'-4"	3'-3"	4'-0"	3'-10"	3'-0"	2'-9"	2'-2"	1'-11"
12"	4'-0"	3'-10"	4'-8"	4'-8"	3'-8"	3'-3"	2'-7"	2'-3"
14"	5'-5"	3'-10"	6'-6"	4'-11"	4'-9"	3'-5"	3'-5"	2'-5"


NOTE:
THIS TABLE IS BASED ON 150 PSI MAIN PRESSURE 2000 PSF SOIL BEARING PRESSURE. WRAP ALL FITTINGS WITH POLYETHYLENE.

THRUST BLOCK DETAIL

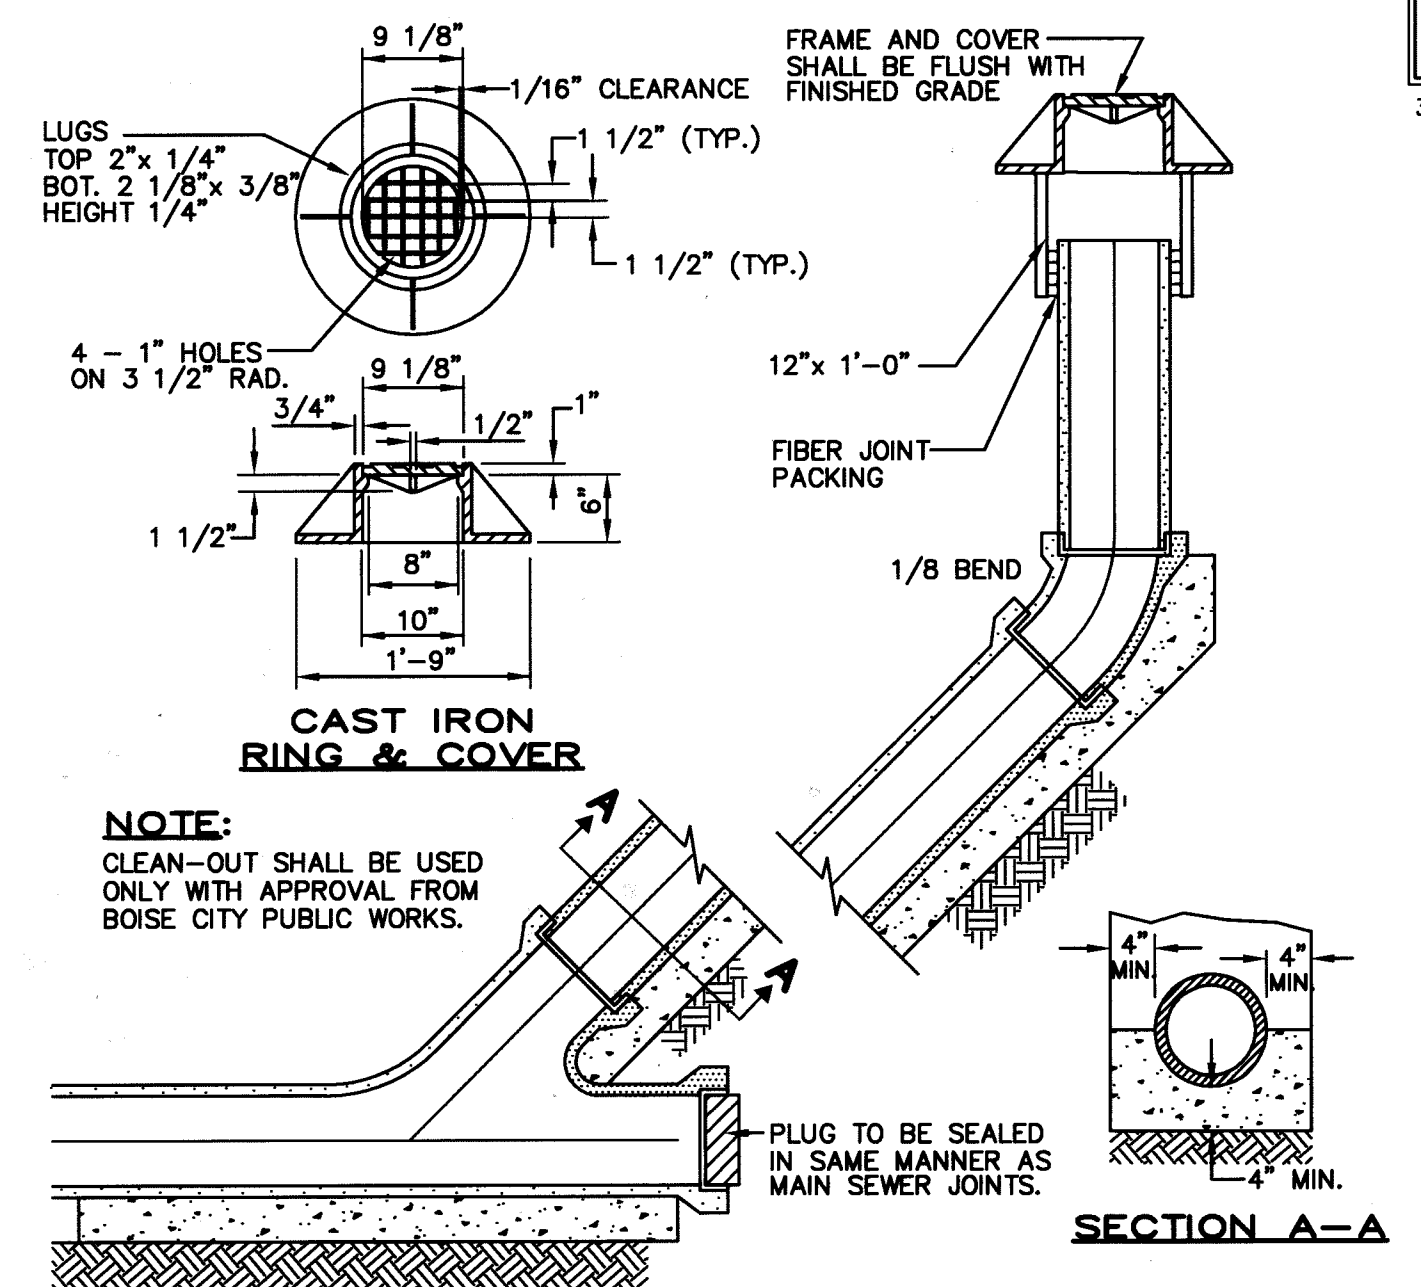


STANDARD 8" TEMPORARY CLEAN-OUT

- 1 20" x 36" PVC TILE, OR APPROVED EQUAL. NOTCH FOR SERVICE LINE(S).
- 2 BRANCH FITTING (FORD U68-43 OR MUELLER H15364).
- 3 1" FEMALE x I.P. "GRIP JOINT" FEMALE ADAPTOR (MUELLER H-1545)
- 4 3/4" BALL VALVE.
- 5 METER YOKE (FORD #93-18).
- 6 2" x 4" x 8", TOP 2" PAINTED BLUE. PROVIDE TEMPORARY PLUG (THREADED IN HIGH GROUNDWATER AREAS).
- 7 1" Ø POLYETHYLENE PIPE.
- 8 NO. 12 COPPER FINDER WIRE.

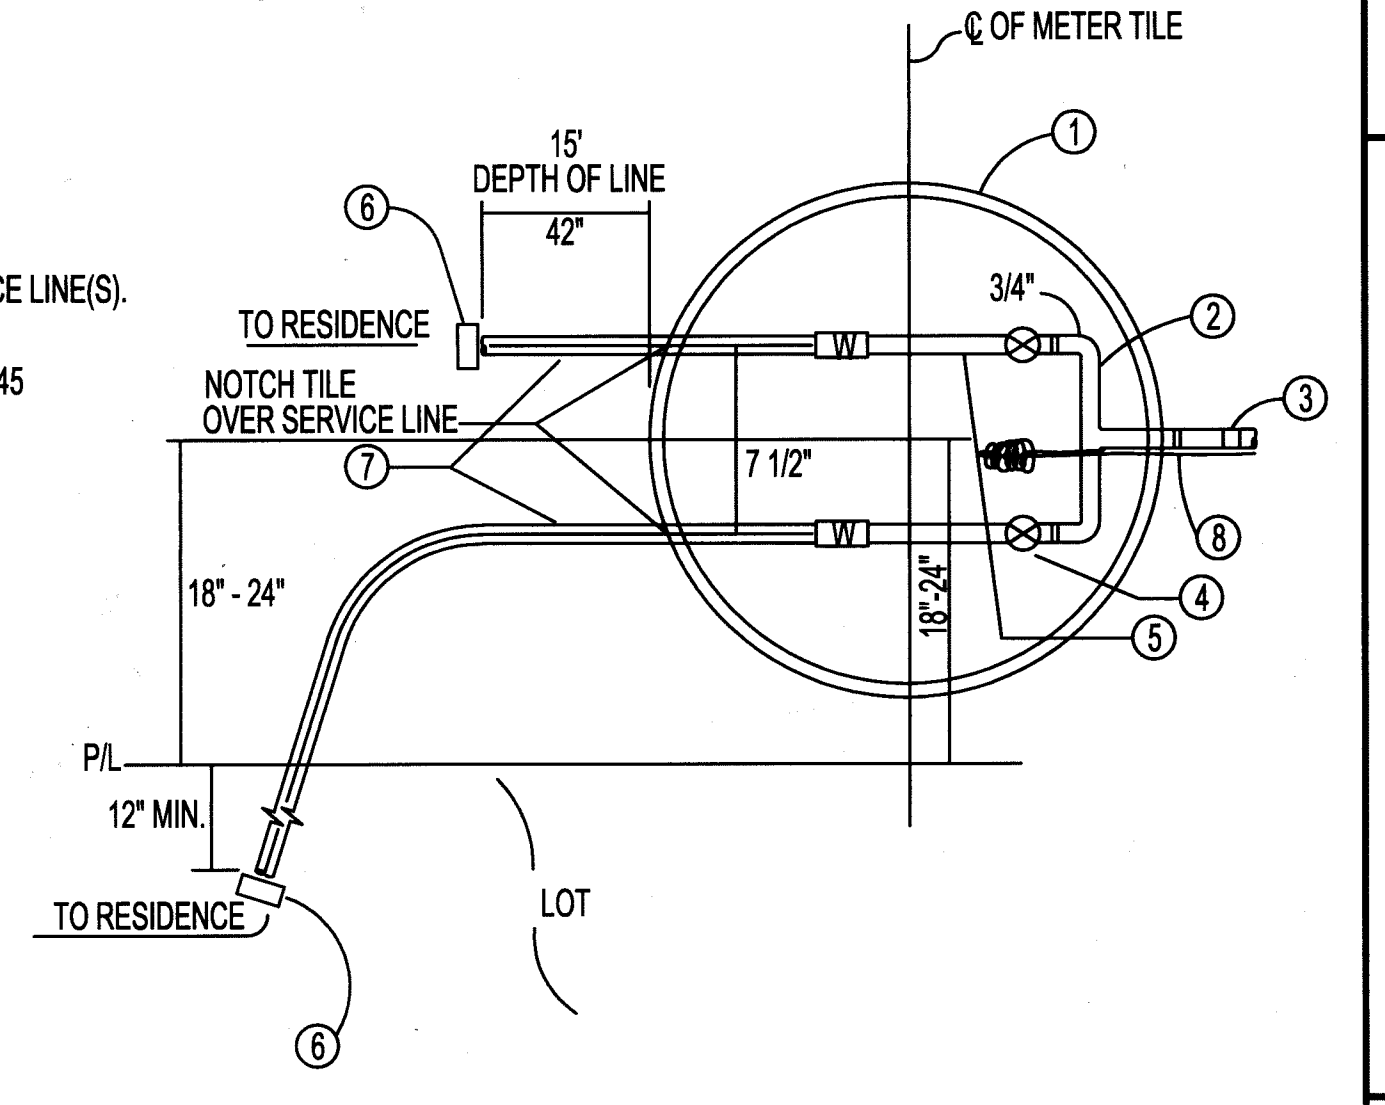

DOUBLE WATER SERVICE INSTALLATION

REVISION: 3/22/04 SFT
7/12/04 BPT

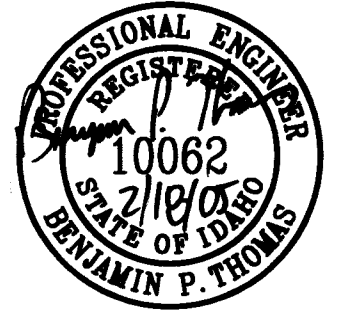

BRIGGS ENGINEERING, INC.
PLANNERS SURVEYORS
1800 W. OVERLAND ROAD • BOISE, IDAHO 83705 • (208) 344-9700
These drawings, or any portion thereof, shall not be used on any project or extension of this project except by written agreement from Briggs Engineering, Inc.

SUTTER'S MILL SUBDIVISION NO. 4
SANITARY SEWER AND WATER DETAILS
SCALE: N.T.S.
DWG. NO. 30204-DTL
SFT
DATE: 10/13/03