
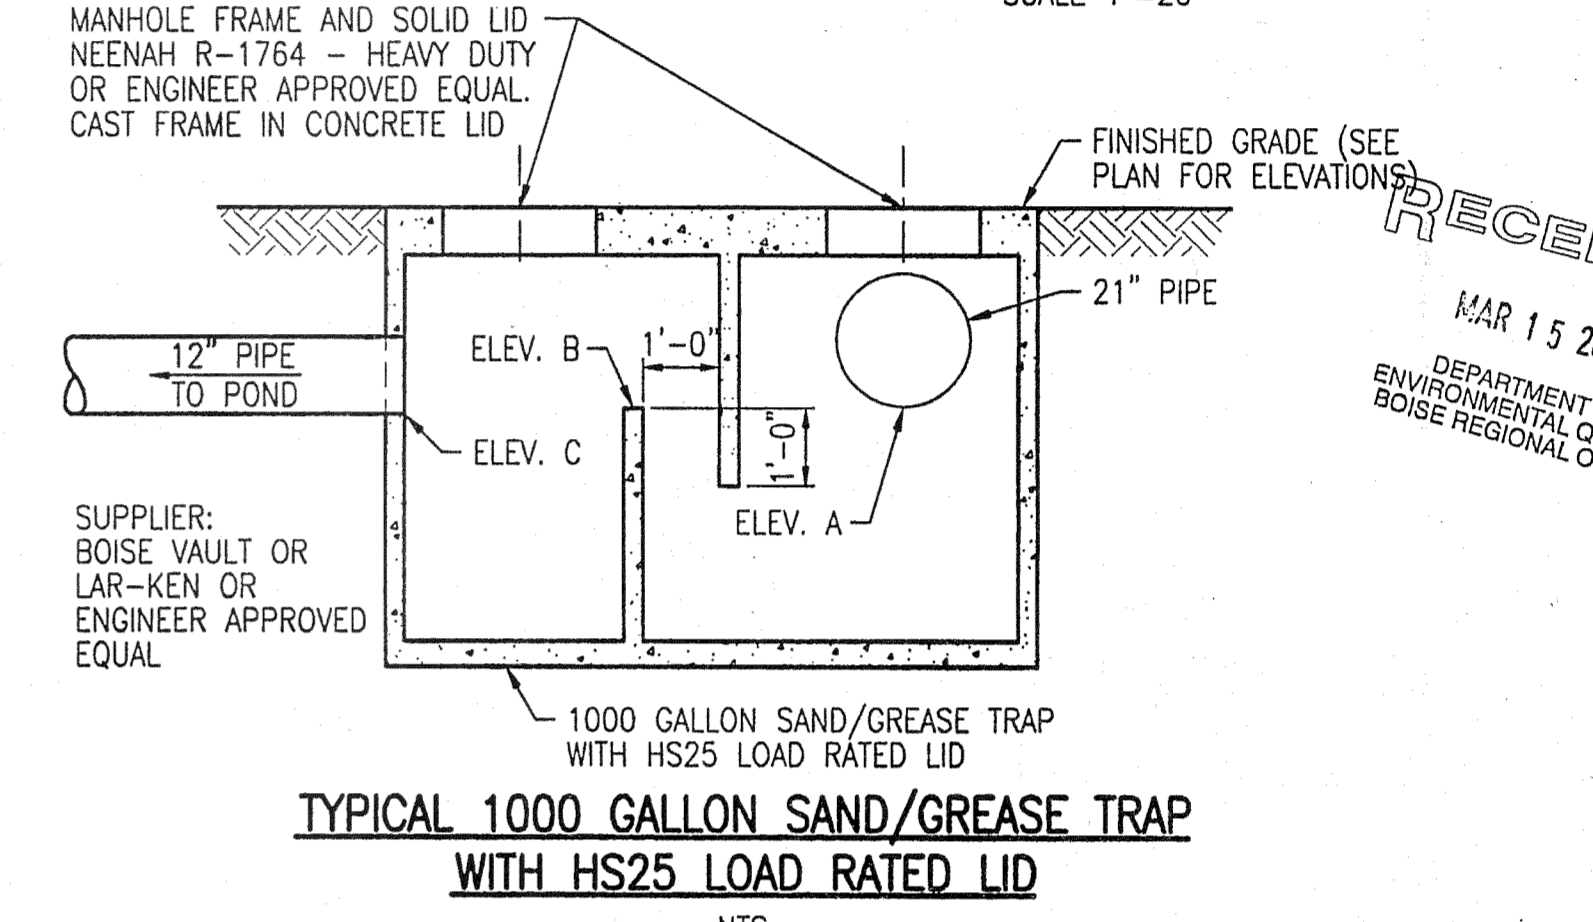


SAND/GREASE TRAP LAYOUT
SCALE 1"=10'


ELEVATION TABLE

TRAP	ELEV. A INV. IN/OUT	ELEV. B TOP OF BAFFLE	ELEV. C INV. OUT
A	2691.68	2691.66	2691.58
B	2691.66	2691.64	2691.56
C	2691.64	2691.62	2691.54
D	2691.62	2691.60	2691.52

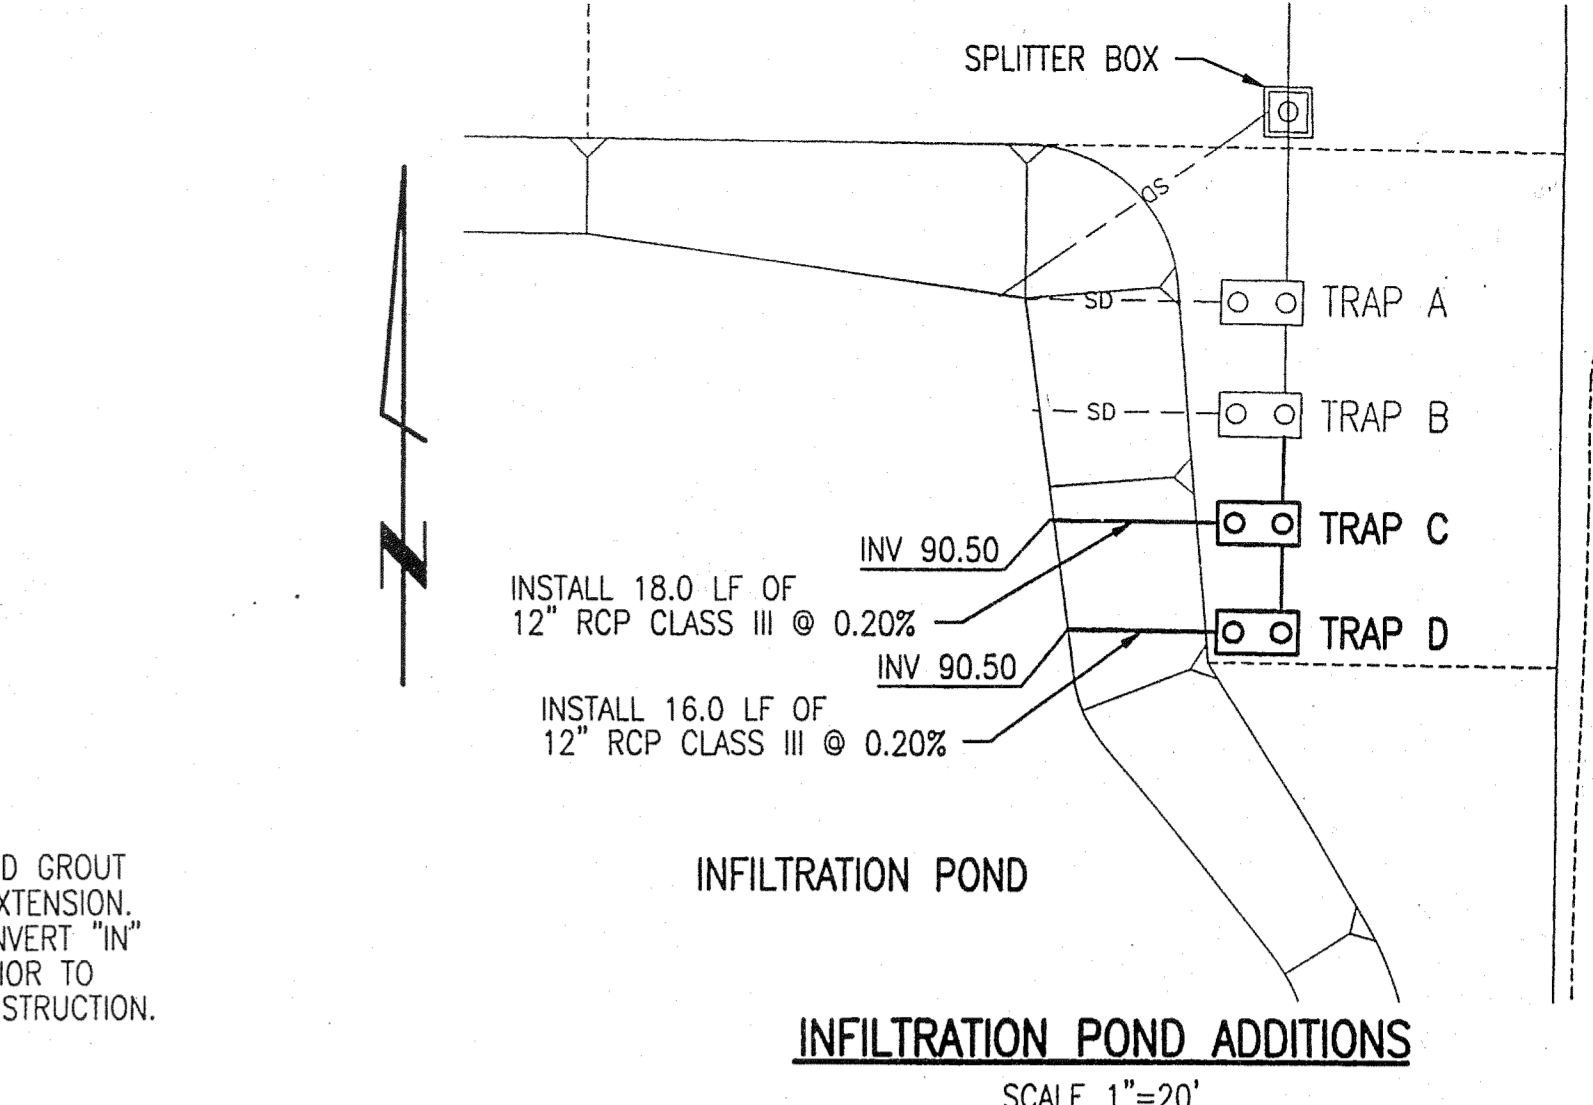

TYPICAL 1000 GALLON SAND/GREASE TRAP WITH HS25 LOAD RATED LID
NTS

RECEIVED
MAR 15 2001
DEPARTMENT OF ENVIRONMENTAL QUALITY
BOISE REGIONAL OFFICE

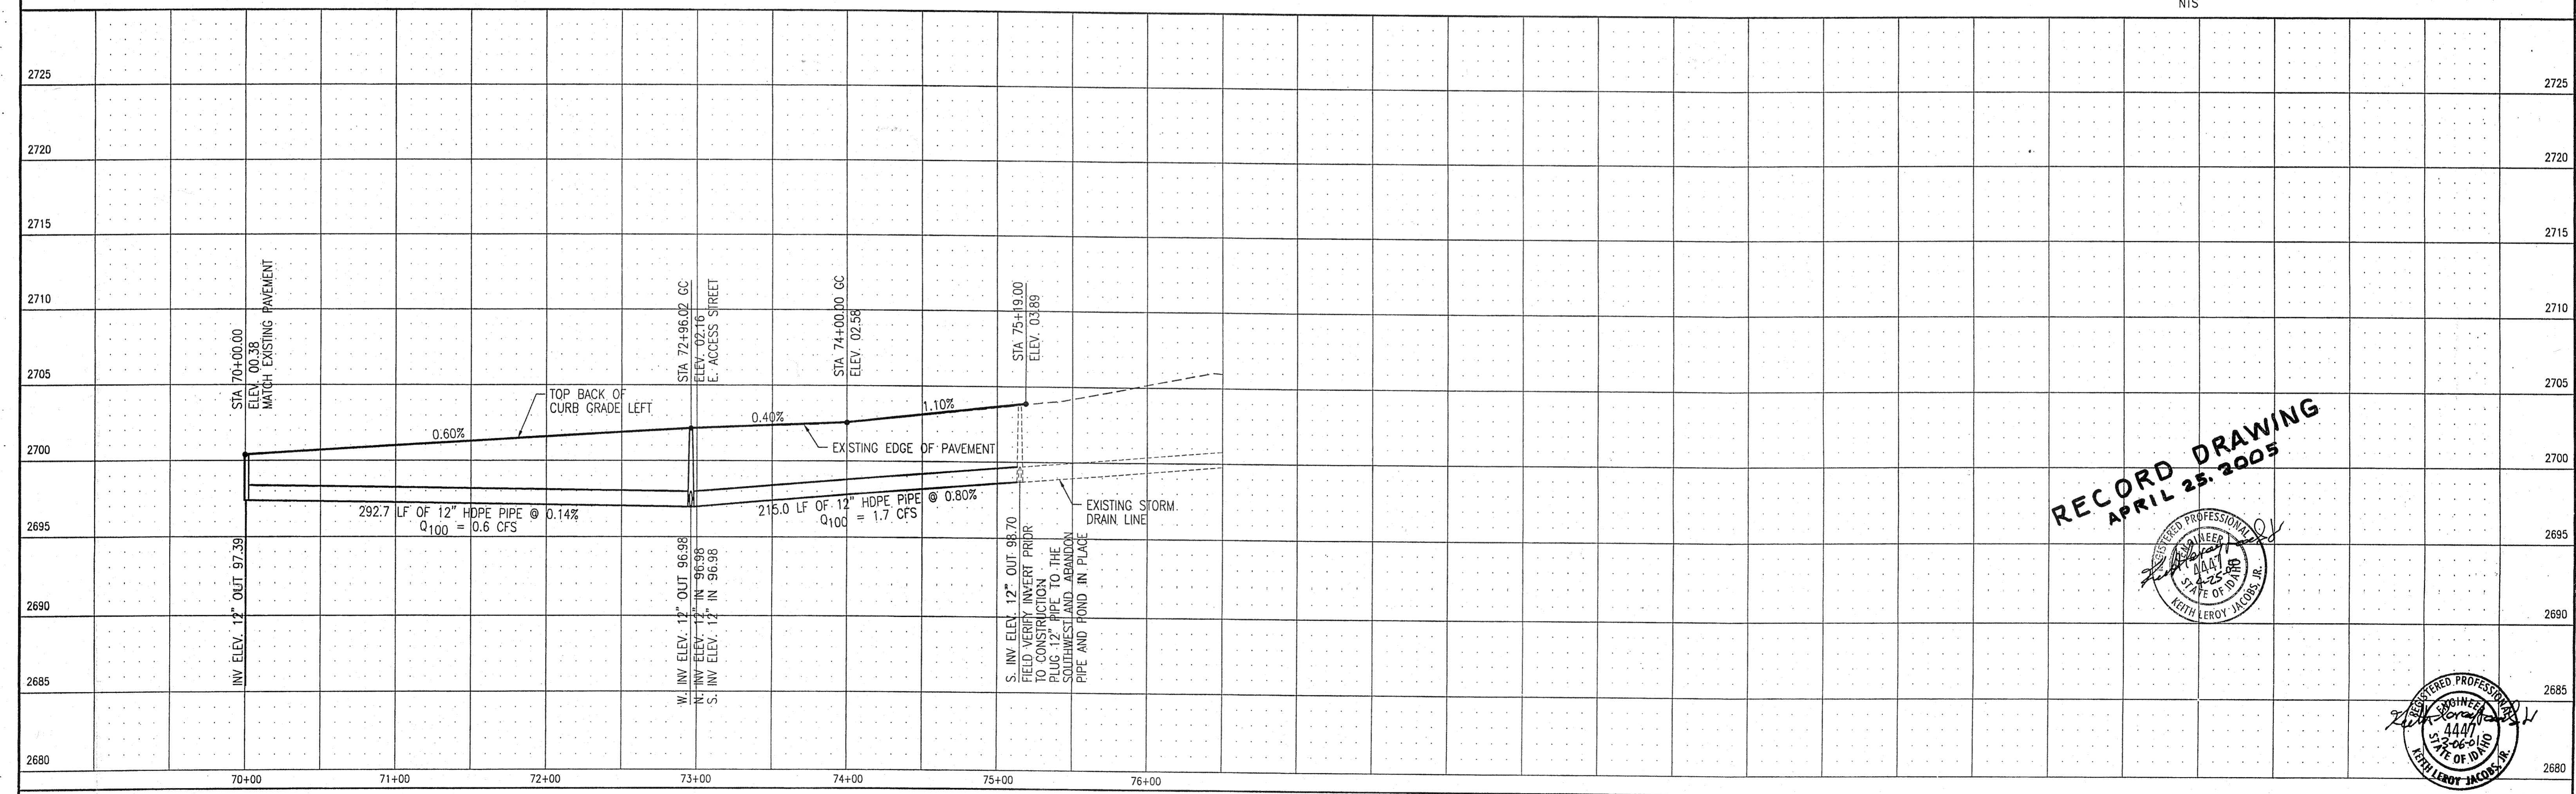

RECORD DRAWING
APRIL 25, 2005

REGISTERED PROFESSIONAL ENGINEER
KEITH LEROY JACOBS, JR.
STATE OF IDAHO
12-22-88
12-22-88

REGISTERED PROFESSIONAL ENGINEER
KEITH LEROY JACOBS, JR.
STATE OF IDAHO
12-22-88
12-22-88

THIS DRAWING WAS PREPARED BY POWER ENGINEERS, INC. FOR A SPECIFIC PROJECT. TAKING INTO CONSIDERATION THE SPECIFIC AND UNIQUE REQUIREMENTS OF THE PROJECT. REUSE OF THIS DRAWING OR ANY INFORMATION CONTAINED IN THIS DRAWING FOR ANY PURPOSE IS PROHIBITED UNLESS WRITTEN PERMISSION FROM BOTH POWER AND POWER'S CLIENT IS GRANTED.										DSGN: KLJ 12/8/00 DRN: DGP 12/8/00 CKD: KLJ 12/8/00 SCALE: AS SHOWN			POWER ENGINEERS 1295 S. EAGLE FLIGHT WAY BOISE, IDAHO 83709 208-378-0022		SWAN FALLS BUSINESS PARK NO. 2 STREET PLAN AND PROFILE S. LUKER ROAD		JOB NUMBER: 527785 DRAWING NO.: C2.2 REV: 1	
REV	REVISIONS	DATE	DRN	DSGN	CKD	APPD	REV	REVISIONS	DATE	DRN	DSGN	CKD	APPD	REFERENCE DRAWINGS				
							▲	ISSUED FOR APPROVAL	3/6/01	DGP	KLJ	KLJ	WSK					
							▲	ISSUED FOR REVIEW	1/12/01	DGP	KLJ	KLJ	WSK					

