

CONSTRUCTION DRAWINGS

OF

DOMESTIC WATER SYSTEM IMPROVEMENTS

EXPANSION NO. 2

FOR

THE CITY OF KUNA

ADA COUNTY, IDAHO

"1976"


TUDOR ENGINEERING CO.

BOISE, IDAHO

RECORDED
DATE 10/26/77
TUDOR ENGINEERING CO.


APPROVED BY THE CITY OF KUNA
DATE 9/7/76

BY: [Signature]
MAYOR

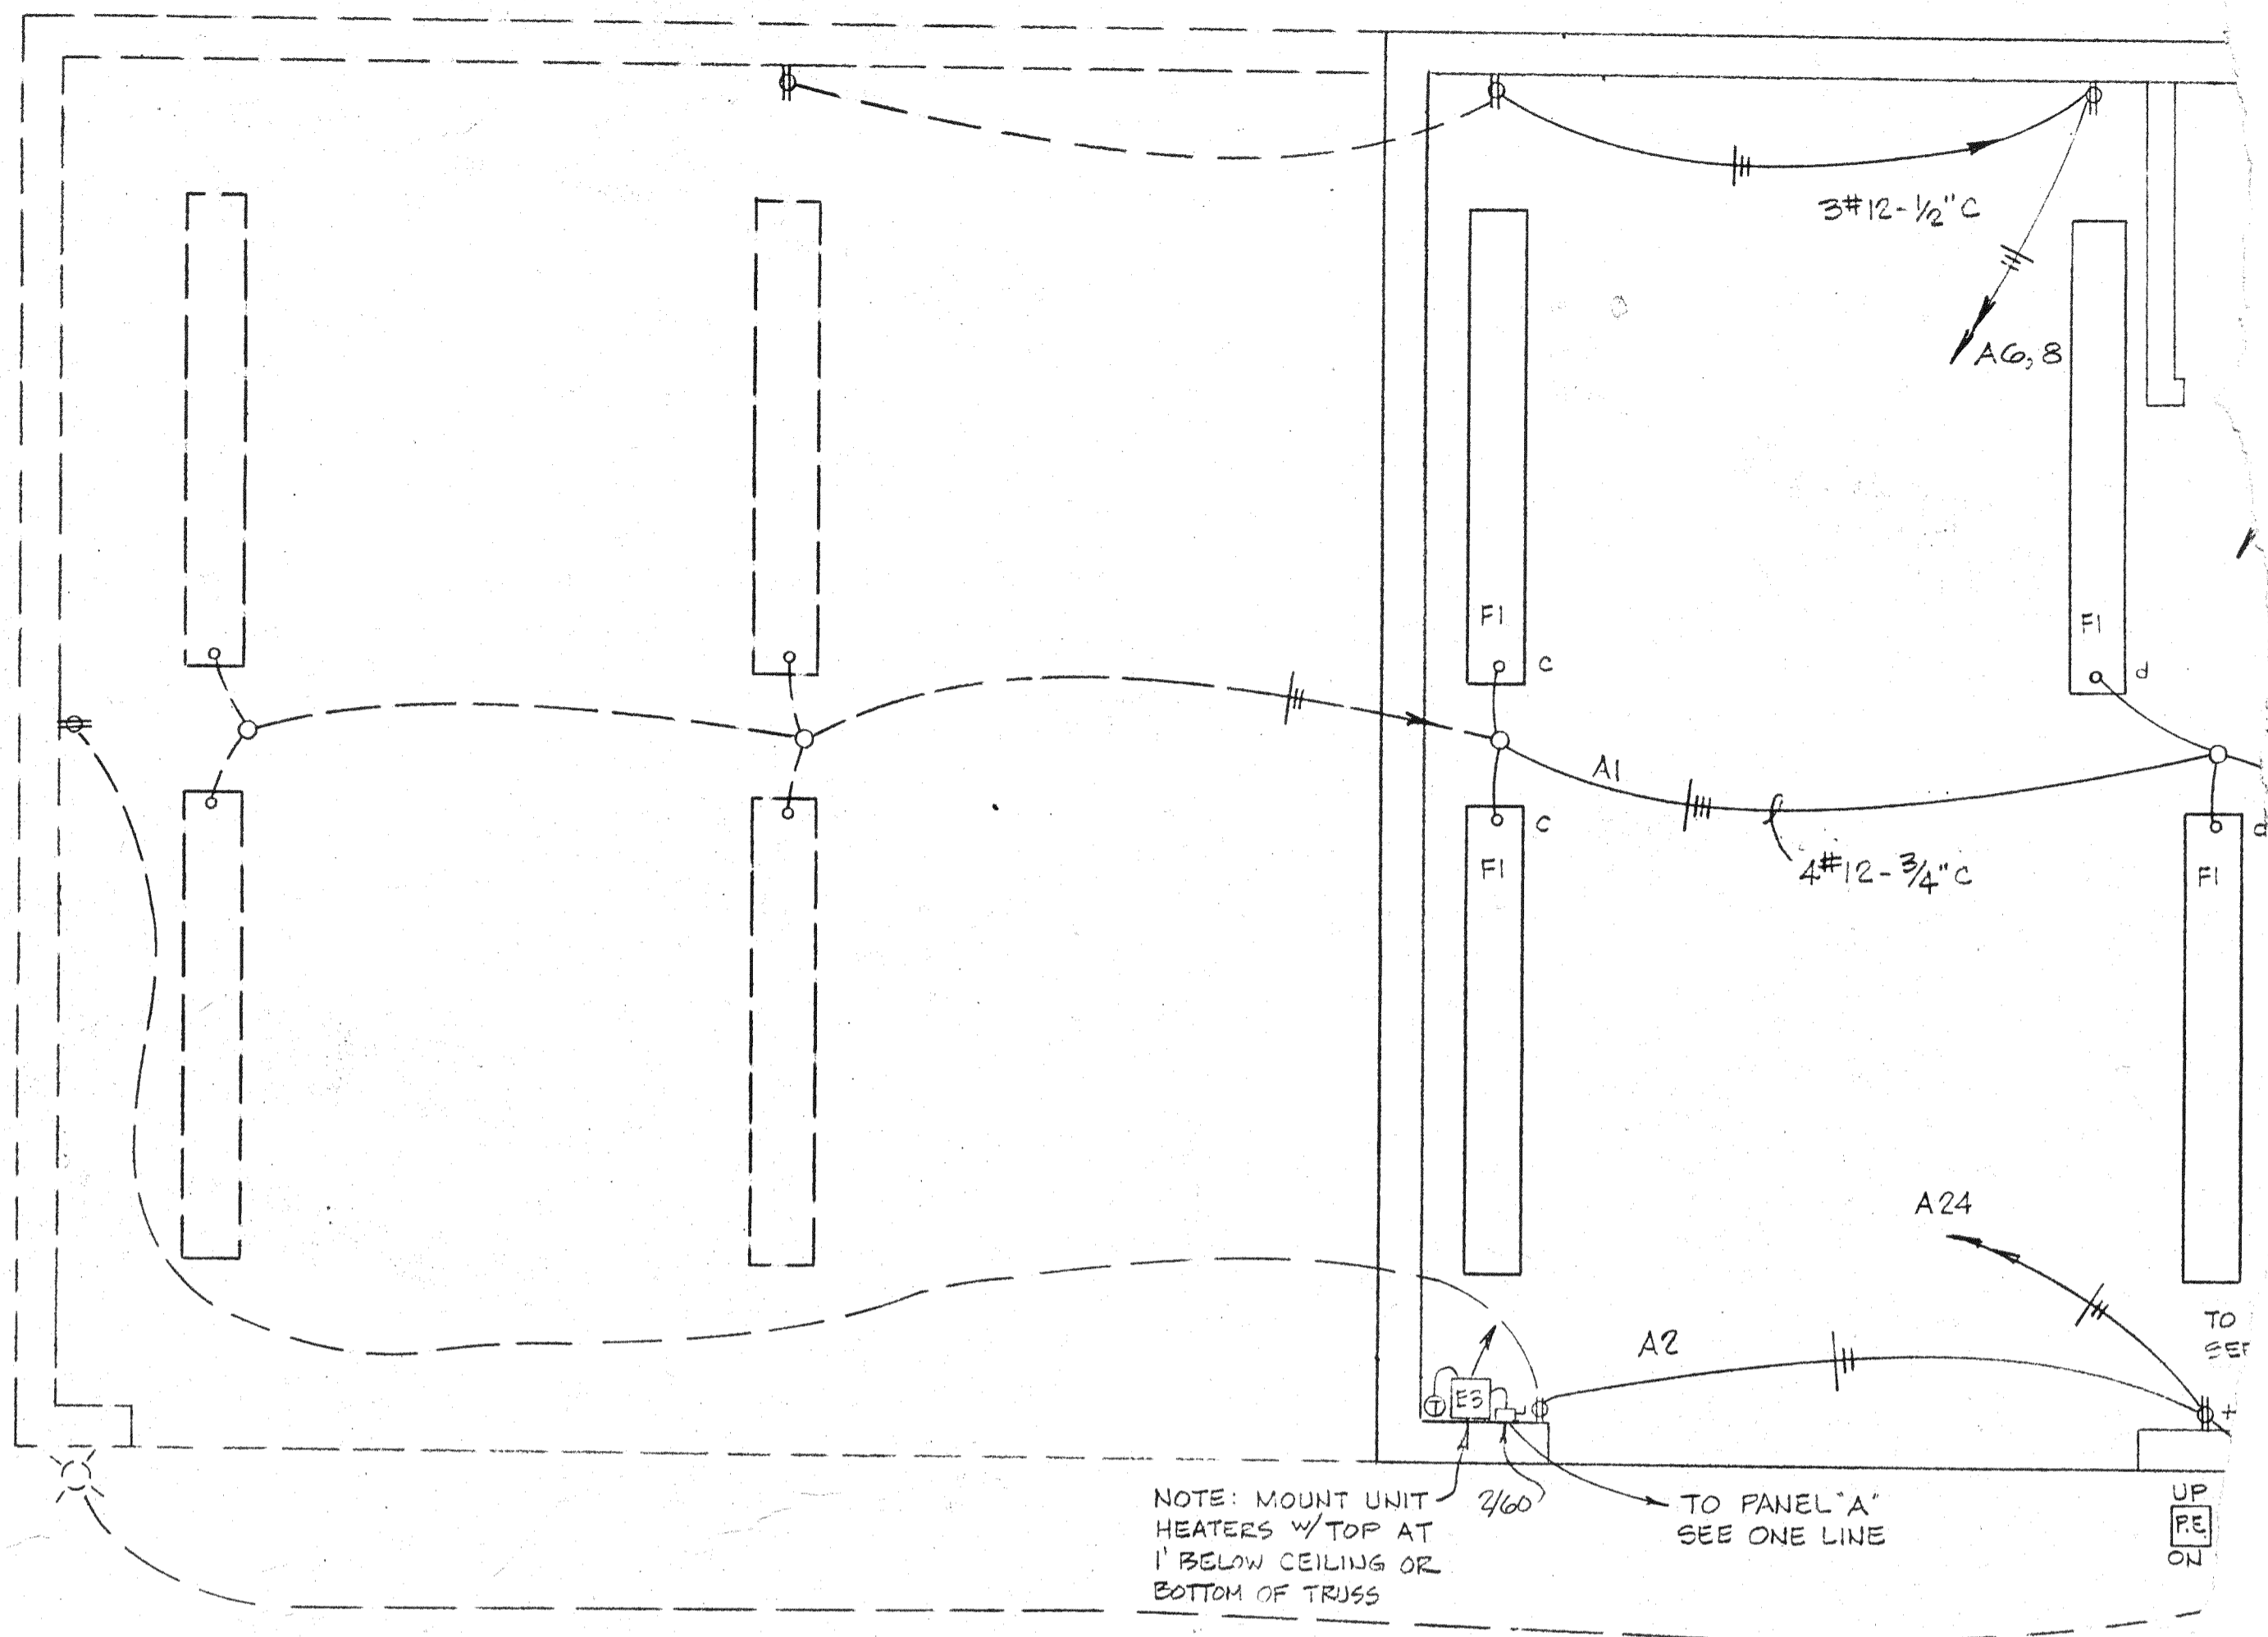

NOTE: MOUNT UNIT HEATERS W/TOP AT 1' BELOW CEILING OR BOTTOM OF TRUSS


ELECTRICAL PLAN

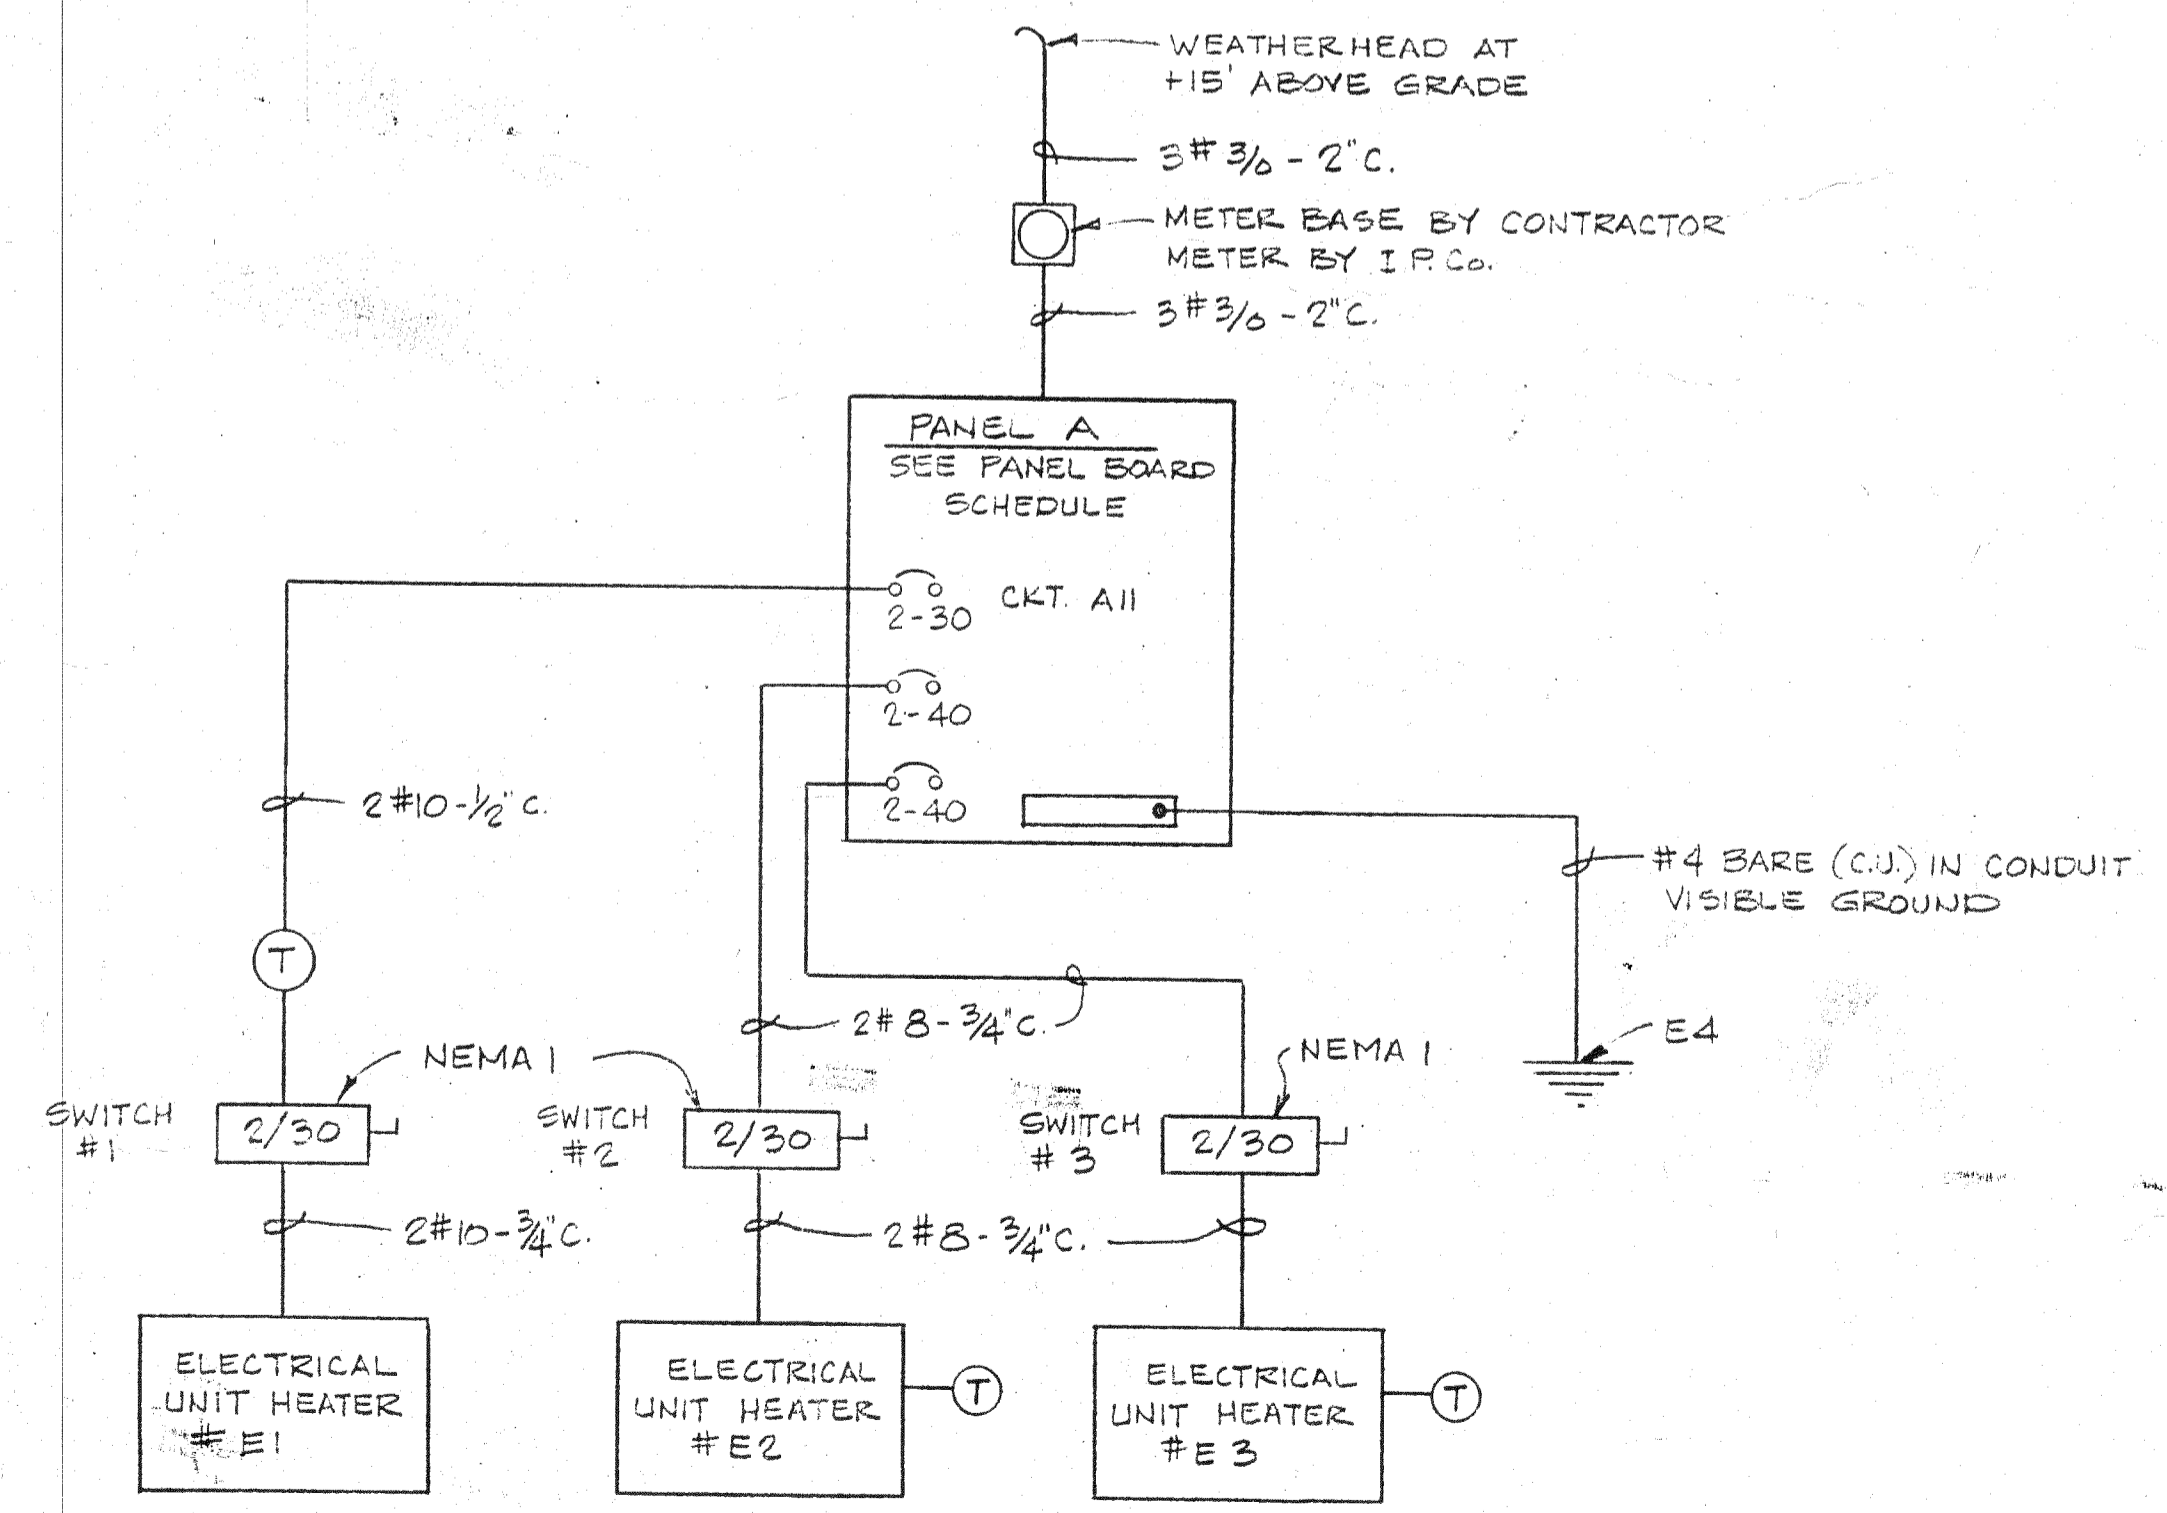

TYPE	LOCATION	
F1	Garage	
F2	Storage	C
F3	Outside	W

ONE LINE DIAGRAM

N.T.S.

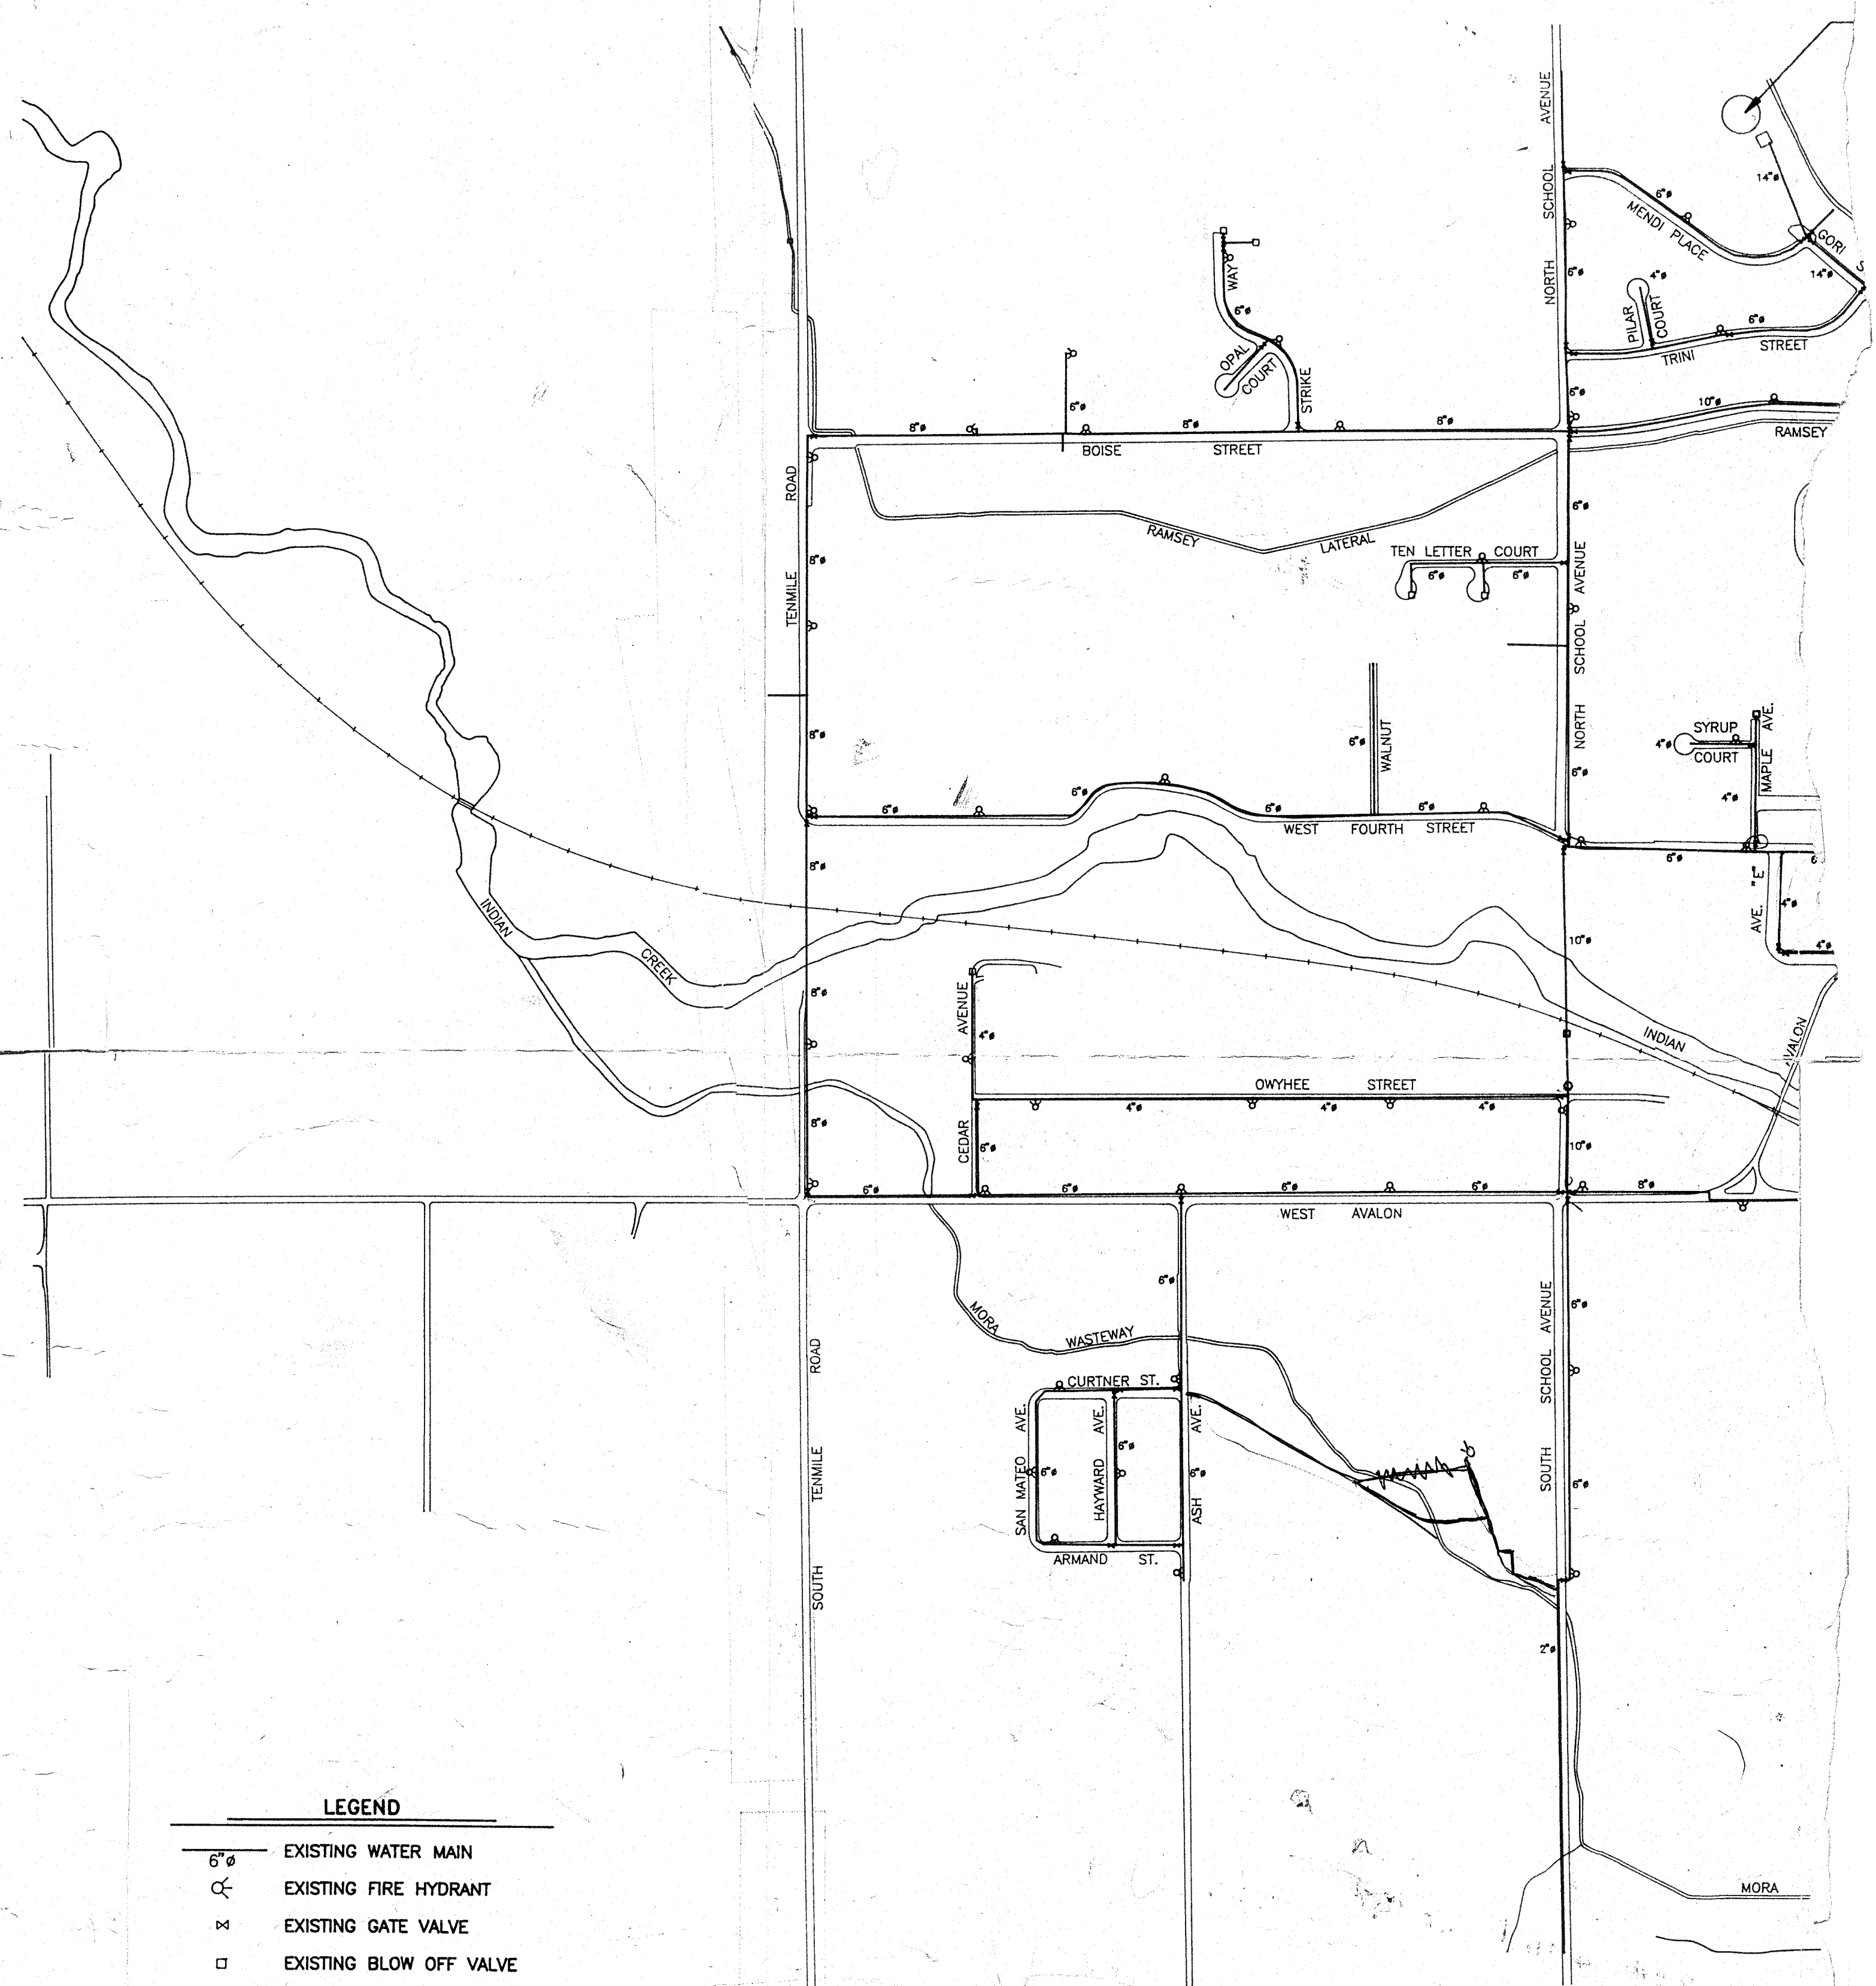

LEGEND

- 8" — EXISTING WATER MAIN
- ⊗ EXISTING FIRE HYDRANT
- X EXISTING GATE VALVE
- EXISTING BLOW OFF VALVE