ASBUILT SURVEY FOR
HIGHMARK / CBH HOMES

A PARCEL OF LAND ALL LOCATED IN SECTION 15 TOWNSHIP 2 NORTH,
RANGE 1 EAST, B.M., CITY OF KUNA, ADA COUNTY, IDAHO
–2018–

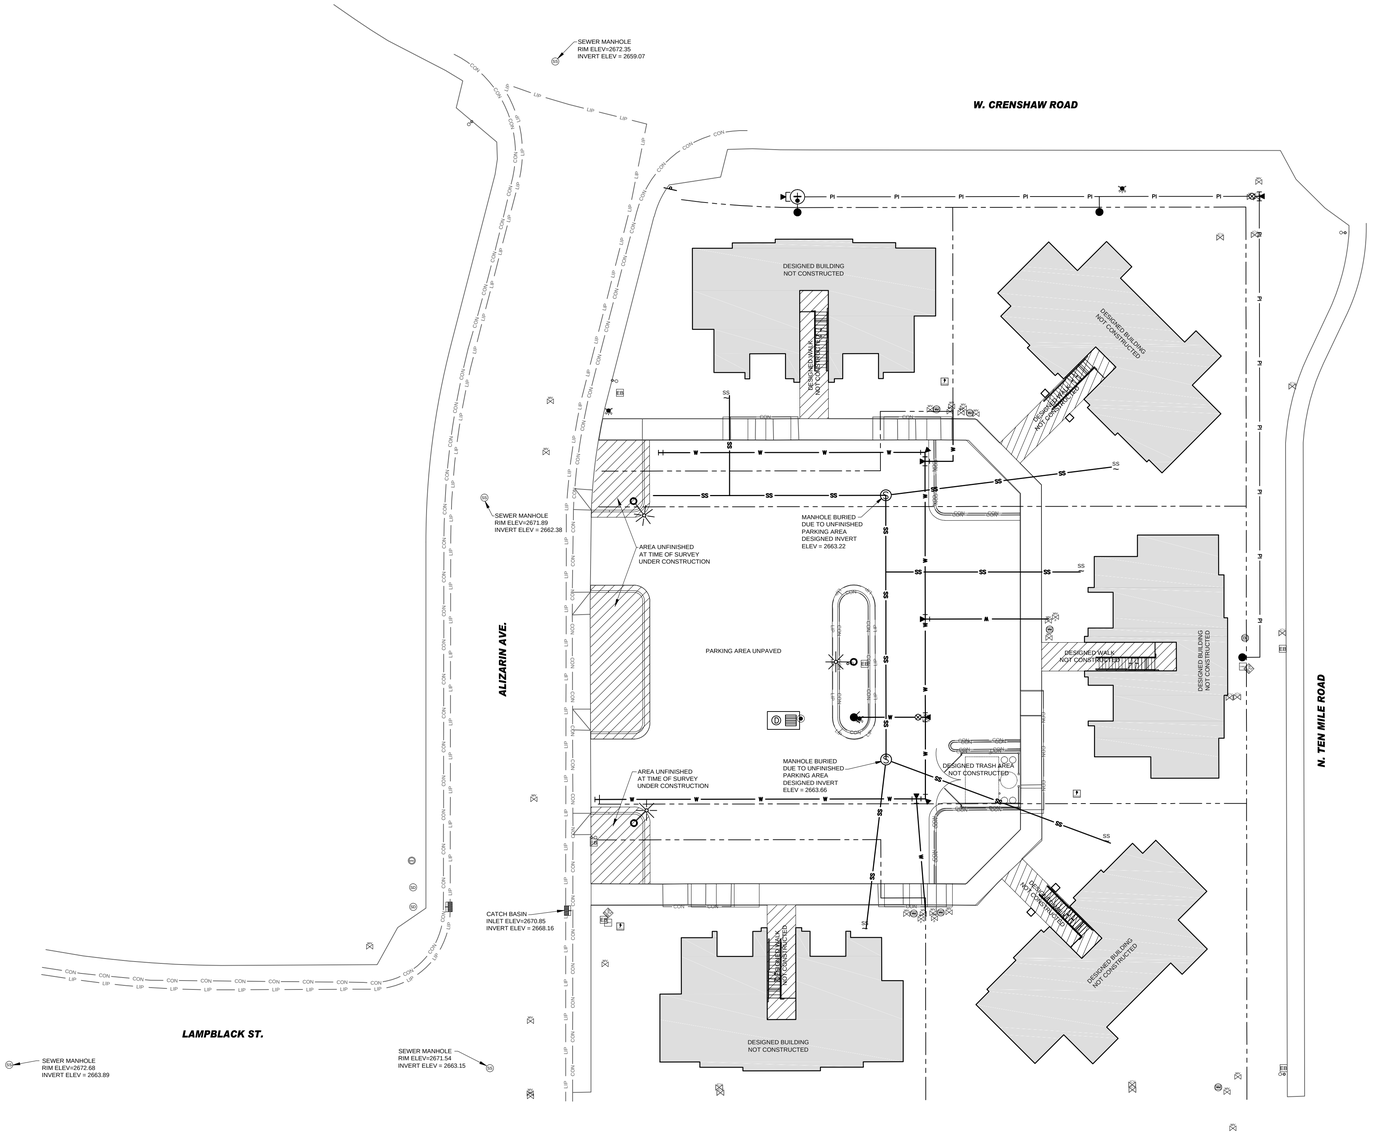

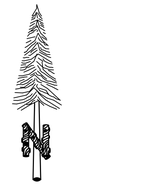

20 0 10 20 40

SCALE: 1"=20'

LEGEND
ASBUILT SYMBOLS

- CABLE TV BOX
- CATCH BASIN
- DROP INLET
- ELECTRICAL BOX
- FIRE HYDRANT
- FIRE WATER VALVE
- IRRIGATION CONTROL VALVE
- LIGHT POLE
- MONITORING WELL
- SANITARY SEWER MANHOLE
- SANITARY SEWER STUB OUT
- SIGN
- STORM DRAIN MANHOLE
- TELEPHONE RISER
- TRANSFORMER
- WATER METER
- WATER VALVE
- EDGE OF CONCRETE
- EDGE OF WALK
- LIP OF GUTTER

NARRATIVE:

This survey was made to reflect what has been constructed on site as of March 19, 2018. Vertical Datum used NAVD 88.

TIMBERLINE SURVEYING
847 PARKCENTRE WAY, SUITE 3, NAMPA, IDAHO 83651
208-465-5687

ASBUILT SURVEY FOR HIGHMARK / CBH HOMES

CLIENT: HIGHMARK / CBH HOMES
JOB NUMBER: 17035
DRAWN BY: DAA
DESIGNED BY: XXX
CHECKED BY: KHC
DRAWING DATE: 3-21-2018

CRIMSON POINT VILLAS NO. 2
KUNA, IDAHO

OWNER/DEVELOPER:
COREY BARTON HOMES
1977 EAST OVERLAND ROAD
MERIDIAN, ID 83642
CONTACT: TIM ECK (208) 286-0520

NO.	DATE	BY	DESCRIPTION

REVISIONS

SCALE: 1" = 20'

SHEET NUMBER: 1 OF 1