BLUE SKY NO.1 SUBDIVISION

STREET PLAN-PROFILE

J-U-B ENGINEERS, INC.
Engineers *Planners*
Boise, Idaho

DES. DR. CK. SHEET 1 OF 4

SCALE Horiz:1"=50', Vert:1"=5' DATE DEC., 1977 DWG. NO. B771228-01-1

Ⓐ REVISED 2/1/78 Street Section on Blue Sky Drive

BENCH MARKS

B.M. Elev.= 2700.60 Spike in East face of Power Pole on West side of Orchard Street and approximately 135' North of intersection of Orchard Street and Teed Lateral.

B.M. Elev. = 2710.51 Chiseled "□" top of concrete wall at Northeast Corner of Bridge at intersection of East 2nd Street and Teed Lateral.

PRELIMINARY

NOTES

1. All work shall be constructed to the Ada County Highway District Specifications, as shown in the latest edition of the "Ada County Highway District Standard Construction Drawings" & shall be approved by the Ada County Highway District Director.
2. All lot dimensions and easements are to be taken from the Plat of Blue Sky No.1 Subdivision.
3. Contractor is to use A.C.H.D. Revised Frame Detail for Drop Inlet, Type II, Modified Catch Basin, Dwg. 302.
4. Sanitary Sewer Manhole Cones and grade rings shall be set to specified elevation by Sanitary Sewer Contractor. All remaining manhole materials necessary to construct manhole to be furnished by the Sanitary Sewer Contractor for placement at finished grade by Street Paving Contractor.
5. Paving on Orchard Street by A.C.H.D. under separate contract.

LEGEND

- 05.66 EG / 9+25.38 — Edge of Gravel / ℄ Station
- 04.76 / 8+45.30 — Top of Curb Elev. / ℄ Station
- 01.55 VC / 6+42.78 — Top of Vertical Curb Elev. at Point of Curve / ℄ Station
- 01.51 RC / 6+52.78 — Top of Roll Curb Elev. End Roll Type Curb Begin Transition to Vertical Curb / ℄ Station
- A.C.H.D. Short Manhole
- SD — Storm Drain Pipe
- 6" Vertical Curb & Gutter & Sidewalk
- Pedestrian Ramp for the Handicapped
- 2" of 3/4" Minus & 6" of 2" Minus Crushed Gravel
- Roll Type Curb & Gutter & Sidewalk
- Catch Basin (Type II, Modified, See A.C.H.D. for Details)

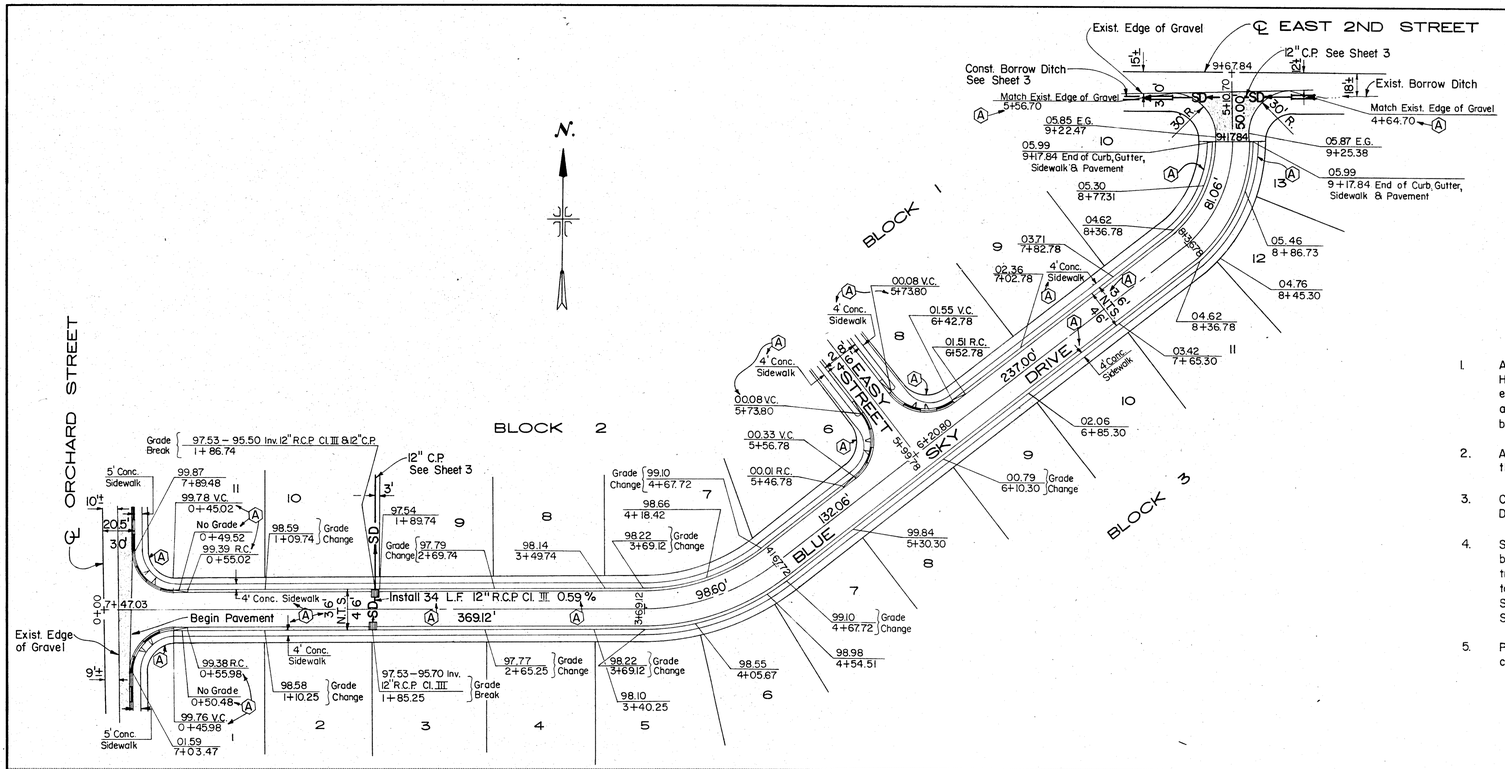

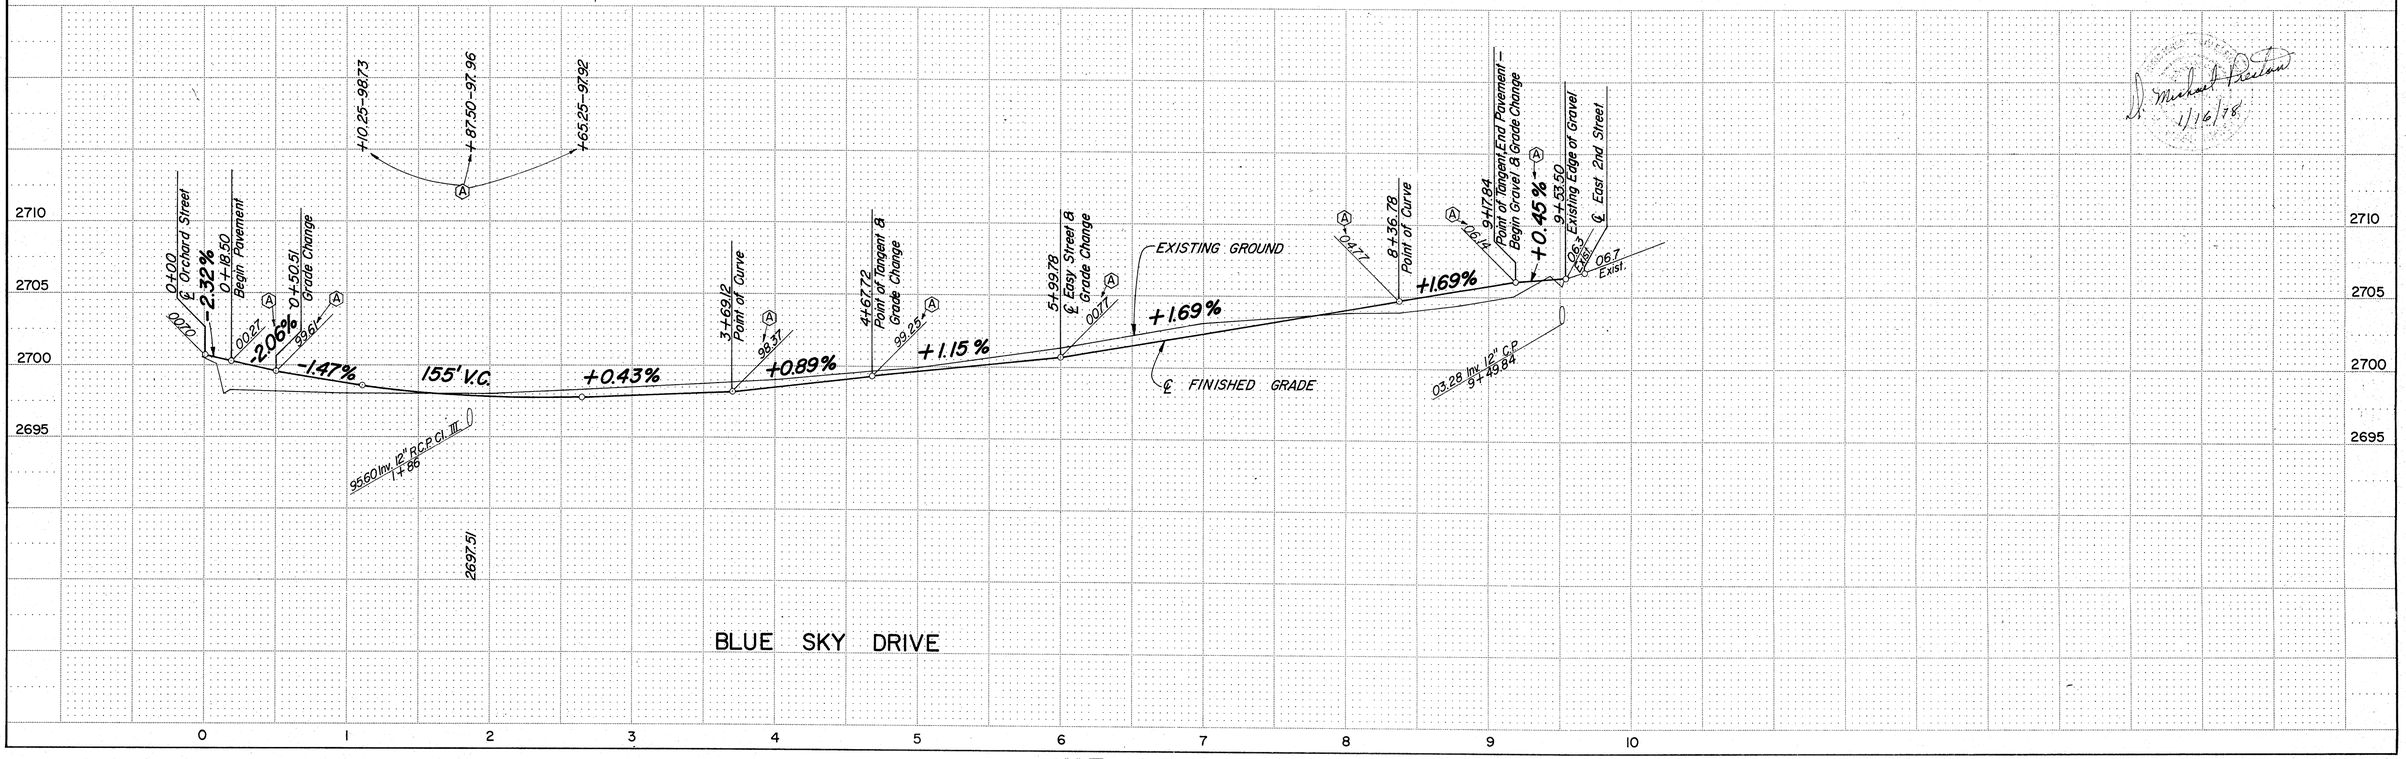

J. Michael Faulkner 1/16/78

REUSE OF DRAWINGS

These drawings, or any portion thereof, shall not be used on any Project or extensions of this Project except by agreement in writing with J-U-B ENGINEERS, Inc.

PLAN — SURVEYED, PLOTTED, NOTE BOOK, No., ALIGNMENT CHECKED, RT. OF WAY CHECKED, BY, DATE

PROFILE — SURVEYED, PLOTTED, NOTE BOOK, No., GRADES CHECKED, R, M.'s NOTED, STRUCTURE REPLACEMENTS CHECKED, BY, DATE

K+E HERCULENE STATIC-FREE DRAFTING FILM CRYSTALENE II TRACING PAPER